

KANSAS

Ellsworth

Section 7 Township 16 Range 10W

Well No. 4 Harbacek

Company N C R A et al

Stoltenberg

NORTH

WEST

EAST

			0				

SOUTH

6

KANSAS Ellsworth

Sec. 7 Twp. 16 R. 10W ✓

Well No. #4 Harbacek Farm

N C R A et al Company

Stoltenberg Pool

 Ft. from N. Line

990'


 Ft. from S. Line

330'

 Ft. from E. Line

 Ft. from W. Line

NE SE NW

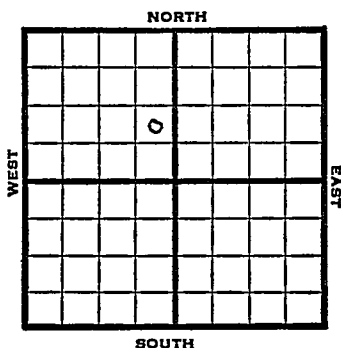

1949

E1 1850'

R E P O R T

6/22 Drlg. 394'

6/28 8" @ 359'

Drlg 2099'

7/6 Lansing 3021'

Arbuckle 3344'

TD 3390'

5" @ 3380'

SWD

7/12

7/20

Abandoned

Arb. 3349'

5" @ 3380'

SWD

TD 3590'

ABANDONED

Map No. _____ Sec. 7 Twp. 16 R. 10W

Well No. 4 Harbacek

N C R A etal. Company

Contractor

NE SE NW

FIRST REPORT
SECTION PLAT

_____ Ft. from N. Line

990 Ft. from S. Line

330 Ft. from E. Line

_____ Ft. from W. Line

Ellsworth County

Location _____

Rig up _____

Drilling and Remarks:

drlg. 394

RECORD

Cased _____ in., _____ ft.

Sand _____

Gas _____

Oil _____

Total Depth _____

PRODUCTION

1st 24 hrs. Nat. _____

1st 24 hrs. after shot _____

Gas _____ Cu. Ft.

Dry Hole _____

Abandoned _____

Date

June 22 1949

S. J. LEWIS Scout

Map No. K55 Sec. 7 Twp. 16 R. 10W

Well No. 4 Harbacek

N C R A et al.

Company

ABANDONED

Contractor

NE SE NW

E. 1. 1888
SECTION PLAT

 Ft. from N. Line

990 Ft. from S. Line

330 Ft. from E. Line

 Ft. from W. Line

	0		

Ellsworth County

Location

Rig up

Drilling and Remarks:

Ac 43349

5" @ 3880

SWD

RECORD

Cased in., ft.

Sand

Gas

Oil

Total Depth 3890

PRODUCTION

1st 24 hrs. Nat.

1st 24 hrs. after shot

Gas Cu. Ft.

Dry Hole

Abandoned

Date

JUL 20 1949 19

S. J. LEWIS

Scout