


Section 7 Township 16 Range 10W

Well No. #5 Harbacek

Company N C R A

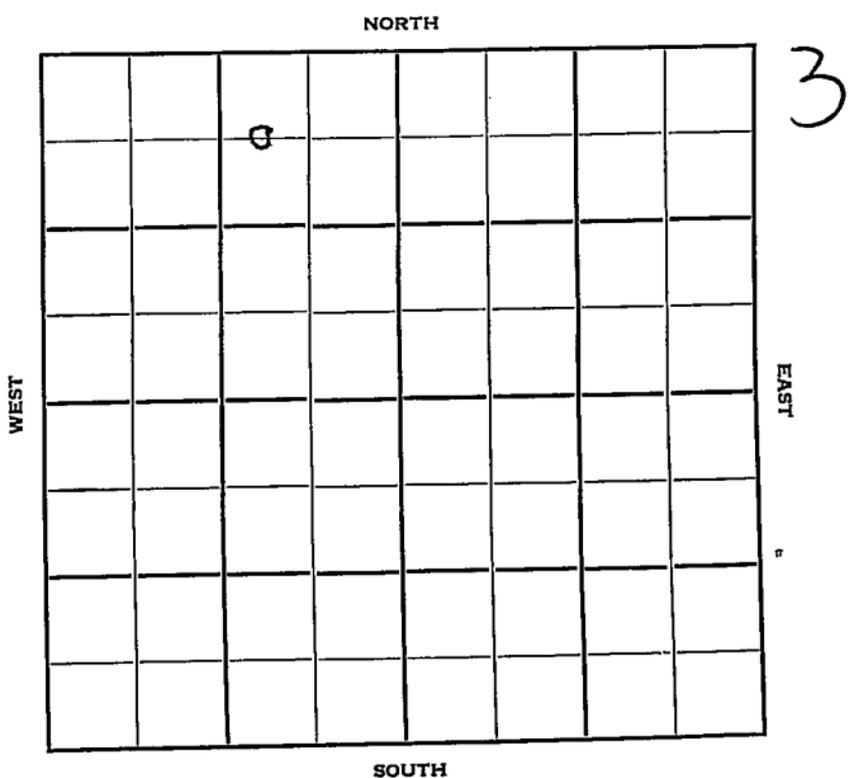

Ellsworth

KANSAS ✓

Sec. 7 Twp. 16 R. 10W

Well No. #5 Harbacek Farm

N-C RA Company

Ashmur Contractor


660 Ft. from N. Line

_____ Ft. from S. Line

990 Ft. from E. Line

_____ Ft. from W. Line

NW $\frac{1}{4}$ **C W** L NE NW

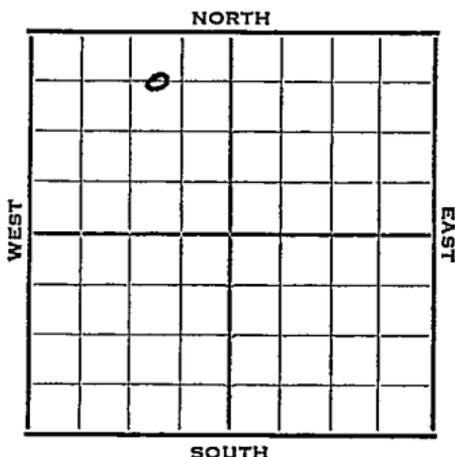

1952 Elev. 1857' REPORT

10/22 Spud 10-15-52
8" @ 355'
Anhy 700'
Drlg. 2270'

10/29 Heeb 2903' Br li 3001' Lans 3022'
Arb. 3334'
DST 3334-37, 2 hrs, 4' SOCM
DST 3336-46, 2 hrs, 2' free oil, 18'
M 350#
Drilling

11/5 Drlg. 3793'

11/12 G. Wash 3827
TD 3966
5" @ 3442'

11/19 Spud 10-15-52 SWD well TD 3966'
8" @ 355' Anhy 700' Heeb 2903'
Br. lime 3001' Lans. 3022'
Arb. 3334'
DST 3334-37 open 2 hr. rec 4' SOCM
DST 3336-46 open 2 hr. rec 2' free oil
18' mud 350# Gr. wash 3827'
TD 3966 5" @ 3442 CO to 3966
1000 A
Comp. for SWD well
ABANDONED

County Ellsworth State Kansas

Sec. 7 (Blk. 16) (Sur. 10W) (Twp.) (Rge.) Map No.

Operator N C R A

Well No. 5 Farm Harbacek

Elev. _____ Location C W L NE NW

	0				

660 Ft. From N Line NW

990 Ft. From E Line Quarter

1st. Report OCT 22 1952

Completion _____

Remarks _____

Ashmur - Contr.

Spudding Date. 10-15-52

Drlg. Data _____

8" @ 355 Aphy 700 drlg. 2270

County Ellsworth State Kansas

Sec. 7 (Blk.) 16 (Sur.) 10W Map No.

Operator N C R A

Well No. 5 Farm Harbacek

Elev. 1857 Location C W L NE NW

660 Ft. From N Line NW

990 Ft. From E Line Quarter

1st. Report

Completion NOV 19 1957

Remarks

Ash-Mur - Contr.

Spudding Date 10-15-52

Drlg. Data SWD well TD 3966

8" @ 355 Anhy 700 Heeb. 2903

Br. lime 3001 Lans. 3022 Arb. 3334

DST 3334-37 open 2 hr. Rec. 4' socm

DST 3336-46 open 2 hr. Rec. 2' free oil

18' mud 350# Gr. wash 3827 TD 3966

5" @ 3442 CO to 3966 1000 A

Comp. for SWD well