

KANSAS

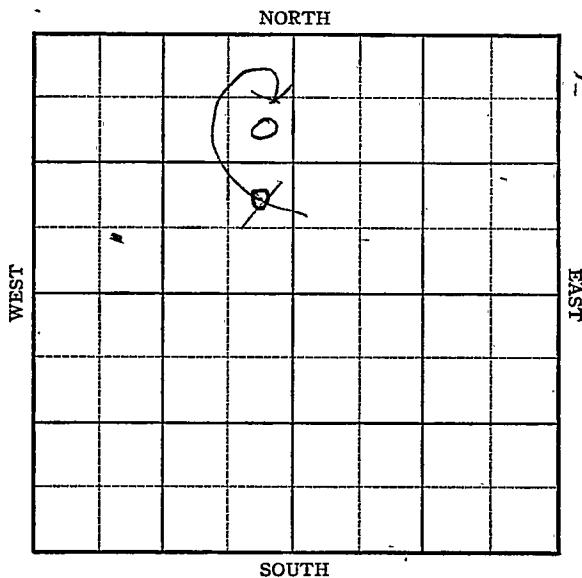
FORM 51 5M 11-44 PETROL

Ellsworth County

Section 7 Township 16 Range 10W

Well No. #2 Harbeck

Company Black-Marshall



KANSAS

Ellsworth County ✓

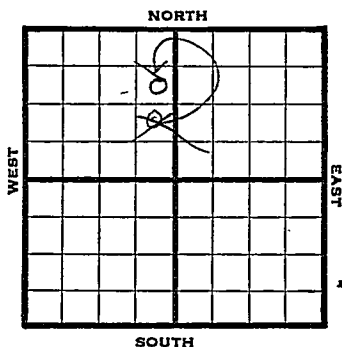
Sec. 7 Twp. 16 R. 10WWell No. #2 Harbeck FarmBlack-Marshall Company

Stoltenberg

990 Ft. from N. Line990 Ft. from S. Line330 Ft. from E. Line       Ft. from W. Line

SE NE

NE SE NW

1946 1856 Elev. REPORT

6/26 Location

7/3 8" @ 356  
Anhy 660  
Drlg 1770'
$$\begin{array}{r} 3327 \\ 1856 \\ \hline 1471 \end{array}$$
7/16 Lans 3020'  
BKC 3307  
Cong 3316  
Arb 3327'  
5" @ 3328'  
TD3343-5000' acid

7/23 " "

7/31 Arb. 3327  
5" @ 3328  
1000 acid.  
TD 3343'  
Pump 128 Pot.  
Grav. 42.0

COMPLETED

KANSAS

Kansas

Pool Name StoltenbergMap No. 55 Sec. 7 Twp. 16 R. 10WWell No. 2 HarbeckBlack-Marshall

Company

## FIRST REPORT

Contractor

NE SE NW

## SECTION PLAT

|  |   |  |  |
|--|---|--|--|
|  |   |  |  |
|  | o |  |  |
|  |   |  |  |
|  |   |  |  |

       Ft. from N. Line990 Ft. from S. Line330 Ft. from E. Line       Ft. from W. LineEllsworth CountyLocation XRig up       

Drilling and Remarks:

## RECORD

Cased        in.,        ft.Sand       Gas       Oil       Total Depth       

## PRODUCTION

1st 24 hrs. Nat.       1st 24 hrs. after shot       Gas        Cu. Ft.Dry Hole       Abandoned       

Date

JUN 26 1946

19

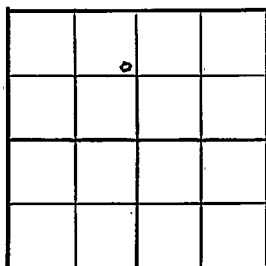
S. J. LEWIS

Scout

KANSAS Kansas Pool Name StoltenbergMap No. 55 Sec. 7 Twp. 16 R. 10WWell No. 2 HarbeckBlack-Marshall CompanyCORRECTION Contractor

SE NE NW

## SECTION PLAT

990 Ft. from N. Line       Ft. from S. Line330 Ft. from E. Line       Ft. from W. LineEllsworth CountyLocation                     Rig up                     

Drilling and Remarks:

Reported

NE SE NW

## RECORD

Cased            in.,            ft.Sand                     Gas                     Oil                     Total Depth                     

## PRODUCTION

1st 24 hrs. Nat.                     1st 24 hrs. after shot                     Gas                      Cu. Ft.Dry Hole                     Abandoned                     

Date

JUL 10 1946

19

S. J. LEWIS Scout

KANSAS Kansas Pool Name Stoltenberg PoolMap No. \_\_\_\_\_ Sec. 7 Twp. 16 R. 10WWell No. 2 HarbeckBlack-Marshall Company**COMPLETED**

SE NE NW

Contractor

E. J. 1806

SECTION PLAT

990 Ft. from N. Line

\_\_\_\_\_ Ft. from S. Line

330 Ft. from E. Line

\_\_\_\_\_ Ft. from W. Line

|  |   |  |  |
|--|---|--|--|
|  |   |  |  |
|  | 0 |  |  |
|  |   |  |  |
|  |   |  |  |
|  |   |  |  |

Ellsworth County

Location \_\_\_\_\_

Rig up \_\_\_\_\_

Drilling and Remarks:

Ar 83275' @ 33281000 acidPump 125 B420 ft**RECORD**

Cased \_\_\_\_\_ in., \_\_\_\_\_ ft.

Sand \_\_\_\_\_

Gas \_\_\_\_\_

Oil \_\_\_\_\_

Total Depth 32243**PRODUCTION**

1st 24 hrs. Nat. \_\_\_\_\_

1st 24 hrs. after shot \_\_\_\_\_

Gas \_\_\_\_\_ Cu. Ft.

Dry Hole \_\_\_\_\_

Abandoned \_\_\_\_\_

Date

JUL 3 1 1946 19 S. J. LEWIS Scout