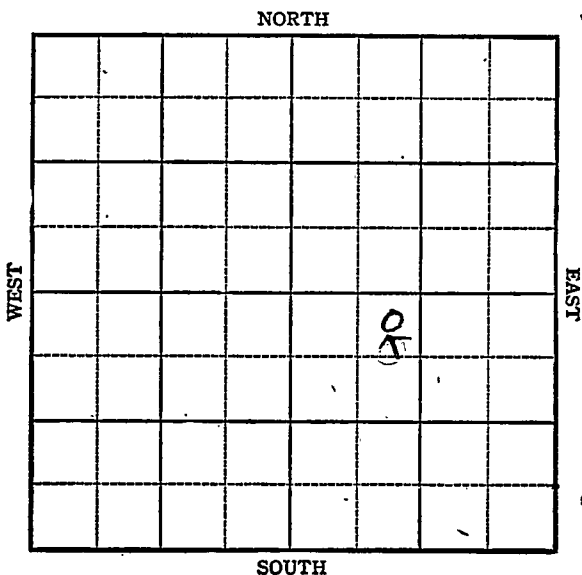


KANSAS

Ellsworth

Section 7 Township 16 Range 10WWell No. #2 JezekCompany Alpine et al

KANSAS

Ellsworth

Sec. 7 Twp. 16 R. 10W

Well No. #2 Jezek Farm
Alpine et al Company


Ellsworth

330
~~660~~ Ft. from N. Line

_____ Ft. from S. Line

_____ Ft. from E. Line

990 Ft. from W. Line

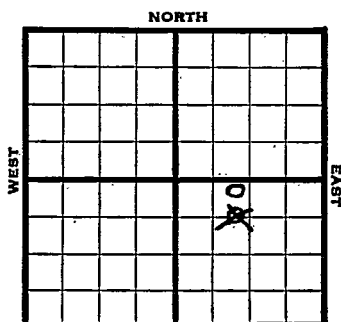

C E L N W S E Ellsworth, 1851

1944

REPORT

8/23
8/30

Rotary
"

9/8

8" @ 352 Drlg. 1695

9/21

" " " " "

9/28

Lansⁿ 3022 " "

Arb 3338

TD 3341 5" @ 3338 RUST

10/4

3346 fsg. bailer

10/11

500 acid swb 2 oil p h.

10/18

Arb 3338

5" @ 3338

500 acid

Pump 50 Pot.

TD 3346

Q_{av}. 42.5

COMPLETED

KANSAS

Pool Name StoltenbergMap No. 55 Sec. 7 Twp. 16 R. 10WWell No. 2 JezekAlpine etal.

Company

FIRST REPORT

Contractor

C E L NW SE

SECTION PLAT

660 Ft. from N. Line Ft. from S. Line Ft. from E. Line990 Ft. from W. Line

Ellsworth County

Location Rig up

Drilling and Remarks:

Rotary

RECORD

Cased in., ft.Sand Gas Oil Total Depth

PRODUCTION

1st 24 hrs. Nat. 1st 24 hrs. after shot Gas Cu. Ft.Dry Hole Abandoned

Date

AUG 23 1944

19

S. J. LEWIS

Scout

Pool Name Stoltenberg~~KANSAS~~Map No. 5 Sec. 7 Twp. 16 R. 10WWell No. 2 JezekAlpine et al.

Company

CORRECTION

Contractor

NE NW SE

SECTION PLAT

330 Ft. from N. Line Ft. from S. Line Ft. from E. Line990 Ft. from W. Line

StoltenbergLocation Rig up

Drilling and Remarks:

Reported

O E L NW SE

RECORD

Cased in., ft.Sand Gas Oil Total Depth

PRODUCTION

1st 24 hrs. Nat. 1st 24 hrs. after shot Gas Cu. Ft.Dry Hole Abandoned

Date

SEP 6 1944 19


S. J. LEWIS

Scout

Pool Name Stoltenberg
 Map No. 55 **KANSAS** Sec. 7 Twp. 16 R. 10W
 Well No. 2 Jazek

Alpine et al. Company
COMPLETED Contractor
NE NW SE

SECTION PLAT

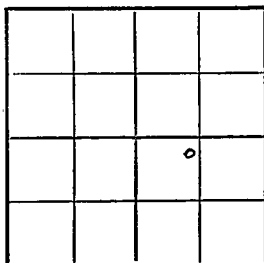

330 Ft. from N. Line
 _____ Ft. from S. Line
 _____ Ft. from E. Line
990 Ft. from W. Line

Ellsworth

Location _____

Rig up _____

Drilling and Remarks:

*At 8338.
 5' to 3338
 500 acid
 Pump 50 psi*

42 5/8

RECORD

Cased _____ in., _____ ft.

Sand _____

Gas _____

Oil _____

Total Depth 62346

PRODUCTION

1st 24 hrs. Nat. _____

1st 24 hrs. after shot _____

Gas _____ Cu. Ft.

Dry Hole _____

Abandoned _____

Date

OCT 1 8 1944 19

S. J. LEWIS Scout