


Section 8 Township 16 Range 10-W

Well No. #1 Kralik

Company Vickers

Stoltenberg Pool

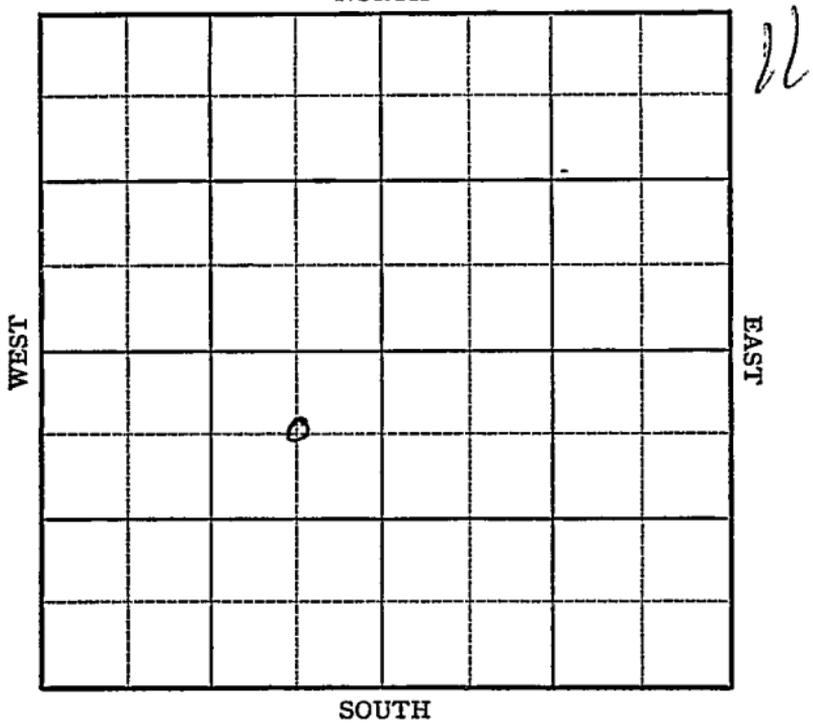

Sec. 8 Twp. 16 R. 10-W

Well No. #1 Kralik Farm

Vickers Company

(Stoltenberg Pool)


660 Ft. from N. Line

 Ft. from S. Line

660 Ft. from E. Line

 Ft. from W. Line

Elev. 1828

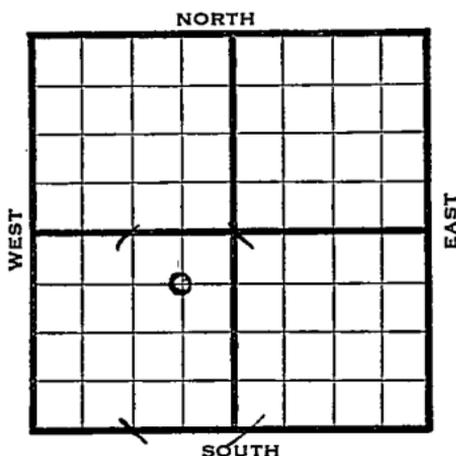

1942

REPORT

- 8/5 Rotary
- 8/12 10" @ 312 Drlg 1250
- 8/19 ~~Land.~~ 2987
Drlg. 3250'
- 8/27 Arb 3298 5" @ 3298 TD 3313 $\frac{1}{2}$ -
50 acid HPO 12 hrs.
- 9/2 " " "
- 9/9 Arb. 3298 5" - 3298
TD 3313 $\frac{1}{2}$
500 acid
Depth Pot. 4374
Max. 3000
Gravity 43.

COMPLETED

Ellsworth

KANSAS

Map No. 55 Sec. 8 Twp. 16 R. 10W

Well No. 1 Kralik

Vickers

Company

FIRST REPORT

Contractor

C NE SW


660 Ft. from N. Line

_____ Ft. from S. Line

660 Ft. from E. Line

_____ Ft. from W. Line

SECTION PLAT

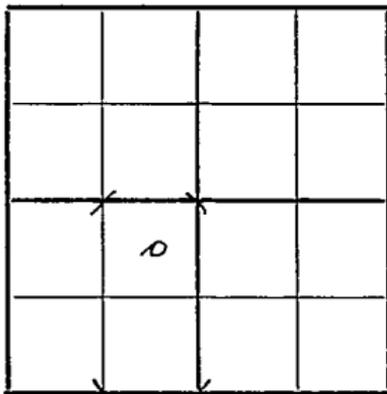

STOLTENBERG POOL

Location _____

Rig up _____

Drilling and Remarks:

Rotary

RECORD

Cased _____ in., _____ ft.

Sand _____

Gas _____

Oil _____

Total Depth _____

PRODUCTION

1st 24 hrs. Nat. _____

1st 24 hrs. after shot _____

Gas _____ Cu. Ft.

Dry Hole _____

Abandoned _____

Date

AUG 5 1942
19

S. J. LEWIS Scout

Ellsworth

KANSAS

Map No. 55 Sec. 8 Twp. 16 R. 10WWell No. 1 KralikVickers Company**COMPLETED** Contractor

C NE SW

660 Ft. from N. Line Ft. from S. Line660 Ft. from E. Line Ft. from W. Line

SECTION PLAT

	o		

STOLTENBERG POOL

Location Rig up

Drilling and Remarks:

Ar 3298
5" @ 3298
500 @ oil
Sept 28 1942 4874
Max 3000
490 @

RECORD

Cased in., ft.Sand Gas Oil Total Depth 3313 1/2

PRODUCTION

1st 24 hrs. Nat. 1st 24 hrs. after shot Gas Cu. Ft.Dry Hole Abandoned

Date

SEP 9 1942 19

S. I. LEWIS Scout