

KANSAS

FORM 51 5M 10-41 PETROL


Ellsworth

Section 8 Township 16 Range 10-W

Well No. #1 Kralik "B"

Company Cities Service Oil

Stoltenberg Pool ^{NORTH}

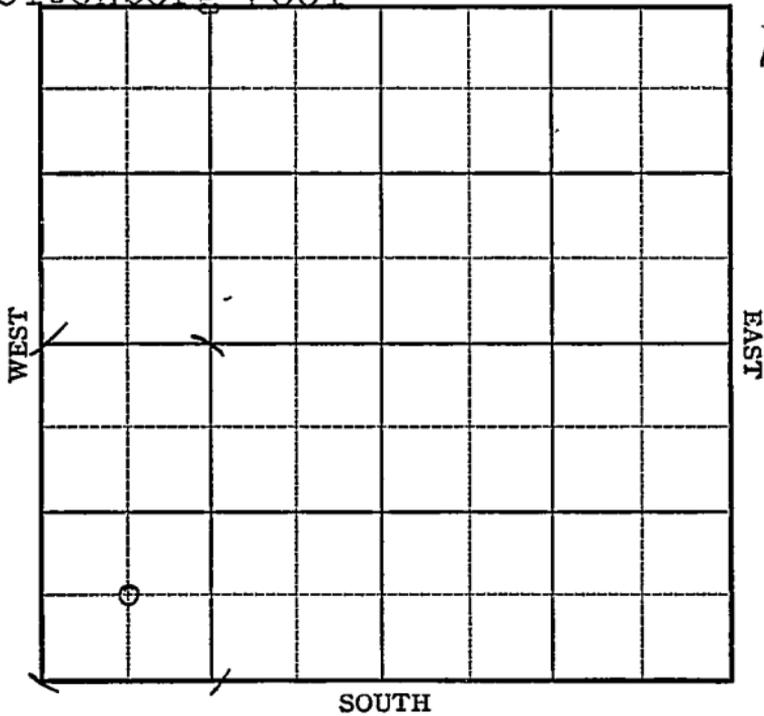

Sec. 8 Twp. 16 R. 10-W

Well No. #1 Kralik "B" Farm

Cities Service Oil Company

(Stoltenberg Pool)


_____ Ft. from N. Line

660 Ft. from S. Line

_____ Ft. from E. Line

660 Ft. from W. Line

Elev. 1849'

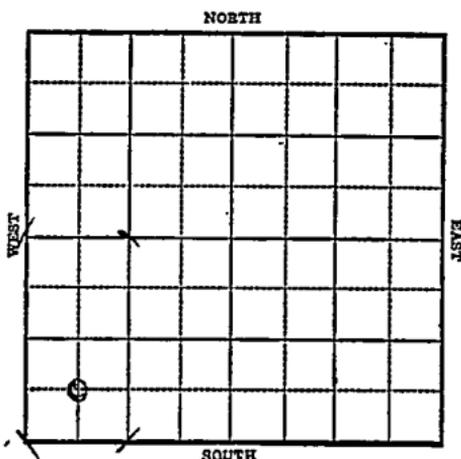

1942

R E P O R T


- 10/7 Location
- 10/14 10" @ 315 WOC
- 10/21 Drlg 2688'
- 10/28 Arp 3308 TD 3311
7" @ 3309 Rust
- 11/4 Arp 3310 corrected
7" @ 3311
TD 3322-415' oil (17 hrs)
Lans 3004 BKc 3240
- 11/11 " " "
- 11/18 " " "
- 11/24 " " "
- 12/2 1500 acid.
- 12/9 SD
- 12/16 "
- 12/22 Arb. 3310
7" @ 3311'
1500 gals. acid
T.D. 3322'
Pump 103 Pot.
Gravity 42.2

COMPLETED

Map No. 55 Sec. 8 Twp. 16 R. 10WWell No. 1 Kralik "B"Cities Service Oil CompanyFIRST REPORT Contractor

C SW SW

SECTION PLAT

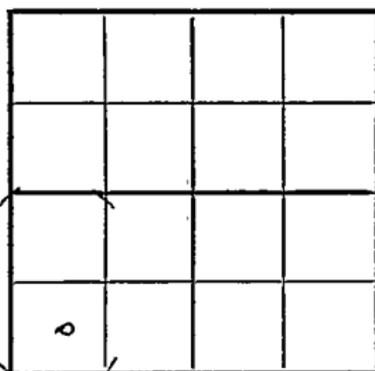

_____ Ft. from N. Line

660 Ft. from S. Line

_____ Ft. from E. Line

660 Ft. from W. Line

STOLTENBERG POOL

Location XX X

Rig up _____

Drilling and Remarks:

RECORD

Cased _____ in., _____ ft.

Sand _____

Gas _____

Oil _____

Total Depth _____

PRODUCTION

1st 24 hrs. Nat. _____

1st 24 hrs. after shot _____

Gas _____ Cu. Ft.

Dry Hole _____

Abandoned _____

Date

OCT 7 1942S. J. LEWIS Scout

KANSAS

Ellsworth

Map No. 55 Sec. 8 Twp. 16 R. 10WWell No. 1 Kralik "B"Cities Service Oil Company**COMPLETED** Contractor

C SW SW

SECTION PLAT

 Ft. from N. Line660 Ft. from S. Line Ft. from E. Line660 Ft. from W. Line

a			

STOLTENBERG POOL

Location Rig up

Drilling and Remarks:

*Cor & 3310**7" @ 3311**1500 @ oil**Pump 103 P.D.**42 2/3 in.*

RECORD

Cased in., ft.Sand Gas Oil Total Depth 3322

PRODUCTION

1st 24 hrs. Nat. 1st 24 hrs. after shot Gas Cu. Ft.Dry Hole Abandoned

Date

DEC 22 1942 19S. J. LEWIS

Scout