

KANSAS

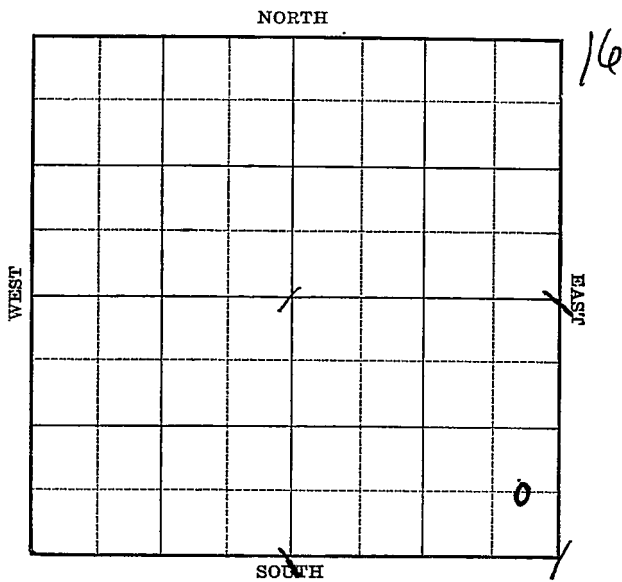
Ellsworth

Form 51—5M—7-39—Palace

Section 8 Township 16 Range 10-W

Well No. #1 W. A. Svoboda

Company Gulf



Sec. 8 Twp. 16 R. 10-W

Well No. #1 W. A. Svoboda Farm **Company**

(Stoltenberg)

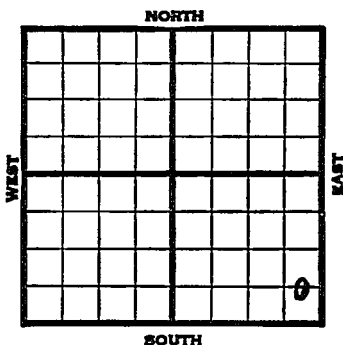
_Ft. from N. Line

660 Ft. from S. Line

330 Ft. from E. Line

Ft. from W. Line

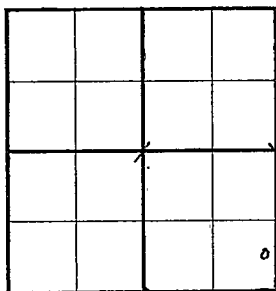
Elev. 1897

[illegible]

Map No. 55 Sec. 8 Twp. 16 R. 10WWell No. 1 W. A. SvobodaGulf

Company

Contractor

SECTION PLATC E $\frac{1}{2}$ SE SE Ft. from N. Line660 Ft. from S. Line330 Ft. from E. Line Ft. from W. Line**STOLTENBERG POOL**Location Rig up

Drilling and Remarks:

Rotary**RECORD**Cased in., ft.Sand Gas Oil Total Depth **PRODUCTION**1st 24 hrs., Nat. 1st 24 hrs., after shot Gas Cu. Ft.Dry Hole Abandoned

Date

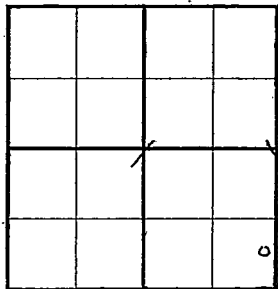
JAN 24 1940 19**S. J. LEWIS**

Scout

Map No. 55 Sec. 8 Twp. 16 R. 10WWell No. 1 W. A. SvobodaGulf

Company

Contractor

COMPLETED**C E $\frac{1}{2}$ SE SE** Ft. from N. Line660 Ft. from S. Line330 Ft. from E. Line Ft. from W. Line**STOLTENBERG POOL****SECTION PLAT**Location Rig up

Drilling and Remarks:

*Cor 83384**5 1/2 @ 3384 1/2**Depthograph Log*
*2551***RECORD**Cased in., ft.Sand Gas Oil Total Depth 3388**PRODUCTION**1st 24 hrs. Nat. 1st 24 hrs. after shot Gas Cu. Ft.Dry Hole Abandoned

Date

MAR 13 1940 19 S. J. LEWIS Scout