

KANSAS

Form 51-5M-7-39-Palace


Ellsworth

Section 8 Township 16 Range 10-W

Well No. #1 Talsky

Company Beardmore Drilling

NORTH Stoltenberg Pool

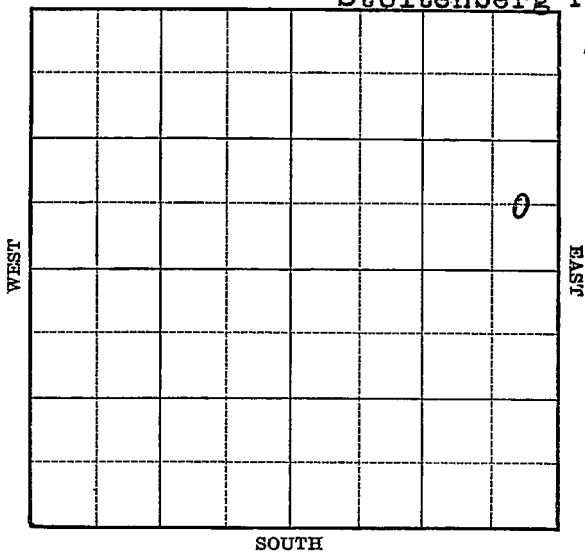

Sec. 8 Twp. 16 R. 10-W

Well No. #1 Talsky Farm

Beardmore Drilling Company


(Stoltenberg)

_____ Ft. from N. Line

660 Ft. from S. Line

330 Ft. from E. Line

_____ Ft. from W. Line

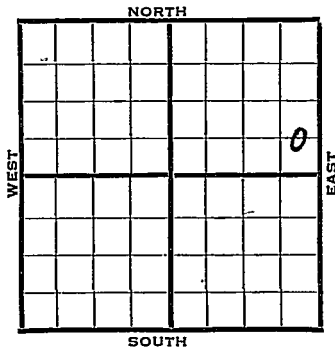

Elev. 1838

1940	REPORT
3/20	Derrick.
3/28	"
4/4	"
4/12	"
4/18	"
4/25	"
5/2	Surface hole.
5/9	8" - 310' Anhy 630'
	Drlg. 2045'
5/16	Arb. 3288-92 ³²⁹⁰ T.D. 5" - 3289 ³²⁹¹
	RUST.
5/23	Arb. 3290' (Corrected)
	5" - 3291' T.D. 3308'
	3000' oil 5 hours.
	OVER

1940
5/29

Arb. 3290'

5" - 3291'

T.D. 3312'

2000 acid.

Echometer potential 5650 bbls.

Maximum 3000 bbls.

COMPLETED

Map No. 53 Sec. 8 Twp. 16 R. 10WWell No. 1 TalskyBeardmore Drilling Company

Contractor

FIRST REPORT**C E L S E N E**

_____ Ft. from N. Line

660 Ft. from S. Line330 Ft. from E. Line

_____ Ft. from W. Line

STOLTENBERG POOL**SECTION PLAT**

			o

Location _____

Rig up _____

Drilling and Remarks:

Derrick**RECORD**

Cased _____ in., _____ ft.

Sand _____

Gas _____

Oil _____

Total Depth _____

PRODUCTION

1st 24 hrs. Nat. _____

1st 24 hrs. after shot _____

Gas _____ Cu. Ft.

Dry Hole _____

Abandoned _____

Date

MAR 20 1940 19

S. J. LEWIS Scout

Map No. 55 Sec. 8 Twp. 16 R. 10W

Well No. 1 Talsky

Beardmore Drilling Company

Contractor

COMPLETED

C E L S E N E

 Ft. from N. Line

660 Ft. from S. Line

330 Ft. from E. Line

 Ft. from W. Line

STOLTENBERG POOL

SECTION PLAT

			2

Location

Rig up

Drilling and Remarks:

CR 83280
5" C 329
2000 acid
Echometer 28
5650
Maximum 3000

RECORD

Cased in., ft.

Sand

Gas

Oil

Total Depth 3312

PRODUCTION

1st 24 hrs. Nat.

1st 24 hrs. after shot

Gas Cu. Ft.

Dry Hole

Abandoned

Date

MAY 29 1940 19

S. J. LEWIS Scout