

KANSAS


Ellsworth

FORM 51 5M 1-42 PETROL

Section 8 | Township 16 Range 10-W

Well No. #2 Kralich "B"

Company Cities Service 0-1

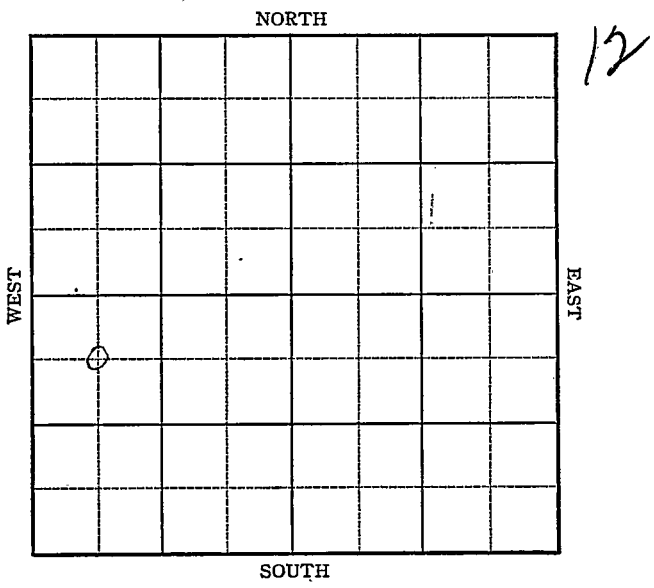

KANSAS

Ellsworth

Sec. 8 Twp. 16 R. 10-W

Well No. #2 Kralich "B" Farm

Cities Service Oil Company

Stoltenberg


660 Ft. from N. Line

_____ Ft. from S. Line

_____ Ft. from E. Line

660 Ft. from W. Line

Ele. 1879

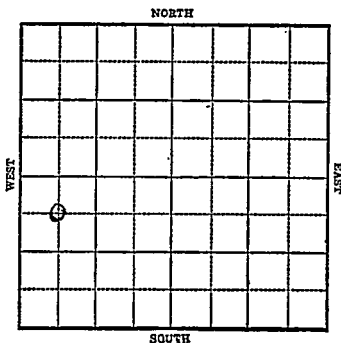

1943

R E P O R T

- 3/24 Rig on Ground
- 3/31 8" @ 321 Drlg. 695
- 4/7 Drlg. 2805'
- 4/14 Arb 3344
T.D. 3358
5" @ 3358 RUST.
- 4/21 T.D. 3348 corrected
5" @ 3348-5000 acid.
- 4/28 Arb. 3344
5" @ 3348'
T.D. 3350'
500 gal acid
Pump 169 Pot.
Gravity 43.7

COMPLETED

Ellsworth

KANSAS

Map No. 55 Sec. 8 Twp. 16 R. 10WWell No. 2 Kralich "B"

Cities Service Oil Company

FIRST REPORT

Contractor

C NW SW

SECTION PLAT

660 Ft. from N. Line

_____ Ft. from S. Line

_____ Ft. from E. Line

660 Ft. from W. Line

o			

STOLTENBERG POOL

Location _____

Rig up _____

Drilling and Remarks:

Rig on Ground

RECORD

Cased _____ in., _____ ft.

Sand _____

Gas _____

Oil _____

Total Depth _____

PRODUCTION

1st 24 hrs. Nat. _____

1st 24 hrs. after shot _____

Gas _____ Cu. Ft.

Dry Hole _____

Abandoned _____

Date

MAR 2 4 1943 19

S. J. LEWIS Scout

Map No. 3535 ^{KANSAS} Sec. 8 Twp. 16 R. 10W

Well No. 2 Kralich "B"

Cities Service Oil Company

COMPLETED Contractor

C NW SW

SECTION PLAT

660 Ft. from N. Line

_____ Ft. from S. Line

_____ Ft. from E. Line

660 Ft. from W. Line

o			

STOLTENBERG POOL

Location _____

Rig up _____

Drilling and Remarks:

Cr 83344
5" C 3348
500 acid
Pump 169 P 8
4.92/br

RECORD

Cased _____ in., _____ ft.

Sand _____

Gas _____

Oil _____

Total Depth 3350

PRODUCTION

1st 24 hrs. Nat. _____

1st 24 hrs. after shot _____

Gas _____ Cu. Ft.

Dry Hole _____

Abandoned _____

Date

APR 28 1943 19

S. J. LEWIS Scout