


Section 1 Township 17 Range 9W

Well No. 1 Brown

Company El Dorado Ref.

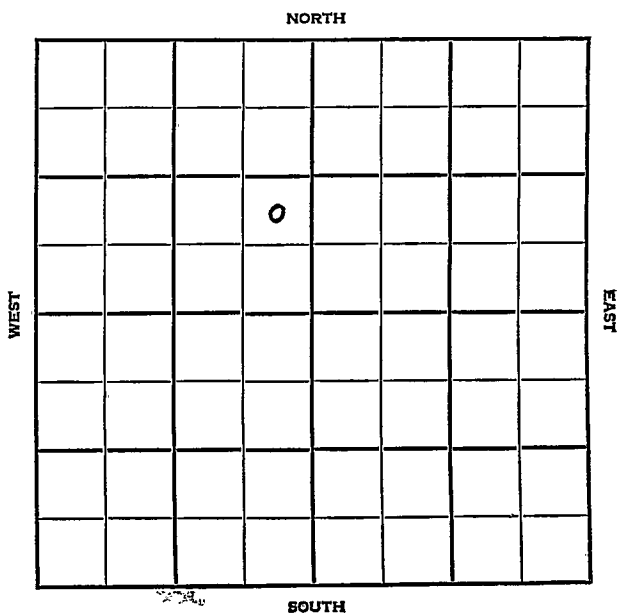

Ellsworth

KANSAS

SEC.	TWP.	R.
1	17	9W


WELL NO. **1 Brown** FARM
 COMPANY

CONTRACTOR **ELDorado Ref.**

Sterling Drlg-Contr

Wildcat (Greengarden Pool)

_____ Ft. from N. Line
 990 _____ Ft. from S. Line
 330 _____ Ft. from E. Line
 _____ Ft. from W. Line

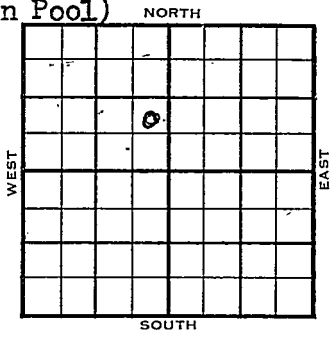

NE SE NW

1954	ELEVATION 1802'	REPORT
------	--------------------	--------

6/2 Location
 6/9 8" @ 284'
 Drlg. 2096'
 7/7 NR
 7/14 Spud 6-3-54
 Oil Well
 TD 3267'
 8" @ 284'
 Heeb 2714', Tor 2733', Br lime 2833',
 Lans 2853'
 DST 3043-57', op 1 hr., rec. 1140'
 gas, 102' OGM, 20" wtr, 880#
 Simp. 3217', Arb. 3264'
 TD 3267'
 5" @ 3267'
 GO to 3252'
 40/3244-49, frac
 SP 3070
 16/3046-50, 20 go 13 gw 4 hrs., 500A
 S/9 1/2 boph 5 hrs.
 P & F/124 bopd 12% wtr.
 C omp. 205 BOPD 4% wtr.

COMPLETED

County Ellsworth State Kansas

Sec. 1 (Blk.) 17 (Sur. Rge.) 9W Map No.

Operator Eldorado Ref.

Well No. 1 Farm Brown

Elev. 1802 Location NE SE NW

990 Ft. From S Line NW

330 Ft. From E Line Quarter

Ist. Report

Completion JUL 14 1954

Remarks Greengarden Pool

Sterling Drlg. - Contr.

Spudding Date 6-3-54

Drlg. Data Oil well TD 3267

8" @ 284 Heeb. 2714 Tor. 2733

Br. lime 2833 Lans. 2853 DST 3043-57

open 1 hr. Rec. 1140' gas 102' ocm

20' wtr. 880# Simp. 3217 Arb. 3264

TD 3267 5" @ 3267 CO to 3252

40/ 3244-49 frac SP 3070 16/ 3046-50

20 go 13 gw 4 hr. 500A S/ 9 1/2 boph

5 hr. P & F/ 124 bopd 12% wtr.

Comp. 205 bopd 4% wtr.

J. G. MCGEE