


Section 1 Township 17 Range 9W

Well Number 1 Brown

Company Empire

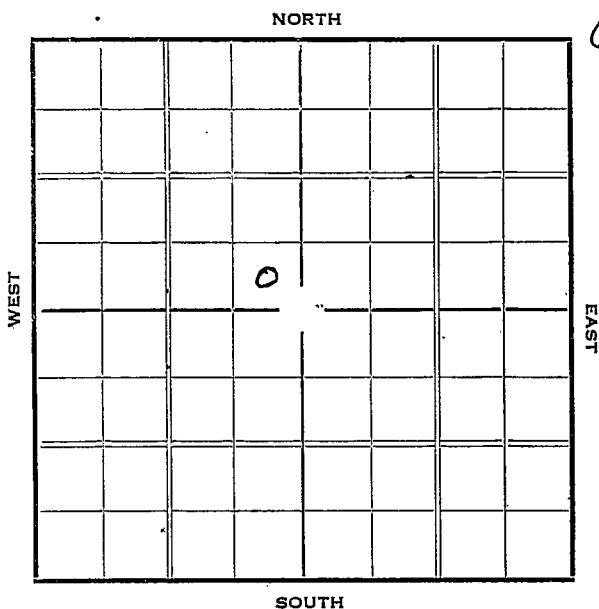

Map No. _____ Sec. 1 Twp. 17 R. 9-W

Well No. #1 Brown Farm _____

Empire Company _____


_____ Ft. from N. Line

330 Ft. from S. Line

330 Ft. from E. Line

_____ Ft. from W. Line

Elev. 1794

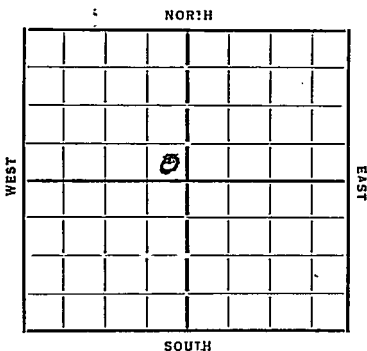

Date	REPORT
1936	
12/2	R O G
12/10	Rigging up
12/17	12" @ 224'. Drlg. 1480'.
12/24	Drlg. 2605'.
12/29	K. C. L. 2858'. Drlg. 2991'.
1937	
1/7	Sil. 3257' Coring.
1937	
1/13	Sil. 3257'. (Corrected)
	T. D. 3288'. D & A.
	ABANDONED

KANSAS

Map No. 45 Sec. 1 Twp. 17 R. 9 W.

Well No. 1 Brown

Empire Company

Contractor

SECTION PLAT

		0	

_____ Ft. from N. Line

330 Ft. from S. Line

330 Ft. from E. Line

_____ Ft. from W. Line

FIRST REPORT

Location _____

Rig up _____

Drilling and Remarks:

ROG

RECORD

Cased _____ in., _____ ft.

Sand _____

Gas _____

Oil _____

Total Depth _____

PRODUCTION:

1st 24 hrs. Nat. _____

1st 24 hrs. after shot _____

Gas _____ Cu. Ft.

Dry Hole _____

Abandoned _____

Date

DEC 2 1936 19

S. J. LEWIS Scout

Map No. 45 Sec. 1 Twp. 17 R. 7W

Well No. 1 Brown

Empire Company

Contractor

SECTION PLAT

_____ Ft. from N. Line

330 Ft. from S. Line

320 Ft. from E. Line

_____ Ft. from W. Line

ABANDONED

Location _____

Rig up _____

Drilling and Remarks:

Oil 3257 corrected

J & A

RECORD

Cased _____ in., _____ ft.

Sand _____

Gas _____

Oil _____

Total Depth 3258

PRODUCTION

1st 24 hrs. Nat. _____

1st 24 hrs. after shot _____

Gas _____ Cu. Ft.

Dry Hole _____

Abandoned _____

Date

JAN 13 1937

19

S. J. LEWIS

Scout