


Map No. KANSAS Sec. 1 Twp. 17 R. 10^W
Well No. 2 - Stratman Farm
Upward et al Company

330 Ft. from N. Line
____ Ft. from S. Line
____ Ft. from E. Line
990 Ft. from W. Line
1932

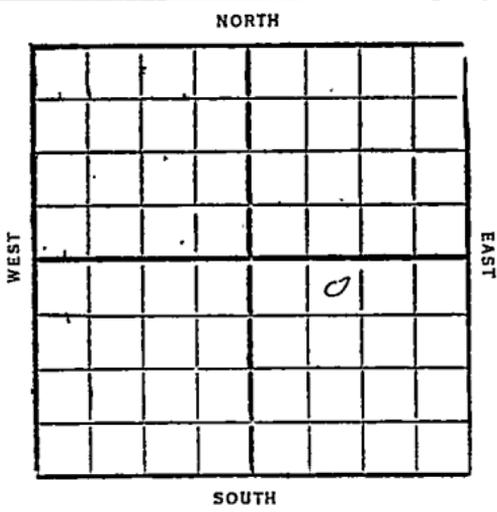

Date	REPORT
1/6	LOG
1/13	Run up
1/20	Spdg 315'
1/27	Wdg 1325'
2/3	" 2210'
2/10	" 2845'
2/17	Top Conglomerate 3231 TD 3247
	Perf 6" - 3193'
2/26	Top Silic 3268-87 swab 94 bbl 1 hr at 3275 swab 102 1/2 bbl 1 hr at 3287
	Run tubing & rods
3/2	TD 3287 No test
3/9	
3/16	Silic lime 3268-87 TD 3287 swab 94 bbl 1 hr at 3275 " 102 1/2 " 1 " at 3287
	No full 24 hr test will be made (over) Comp.

1932
3/30 - Silic lime 3268-87
T.D. 3287

Potential prod -
Pump 1918 bbls 24 hrs
Comp

Ellsworth

55 KANSAS

Map No. _____ Sec. 1 Twp. 17 R. 10 ^W

Well No. 2 Stratman

Aylward & al Company

Contractor

FIRST REPORTS


330 Ft. from N. Line

_____ Ft. from S. Line

_____ Ft. from E. Line

990 Ft. from W. Line

SECTION PLAT

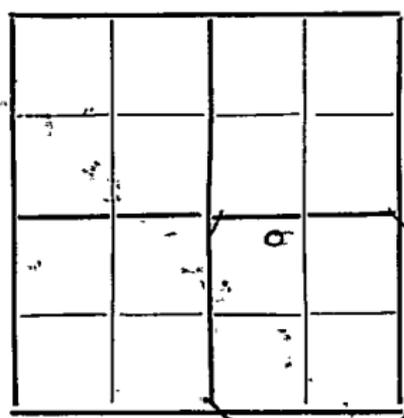

Location _____

Rig up _____

Drilling and Remarks:

RECORD

Cased _____ in., _____ ft.

Sand _____

Gas _____

Oil _____

Total Depth _____

PRODUCTION

1st 24 hrs. Nat. _____

1st 24 hrs. after shot _____

Gas _____ Cu. Ft.

Dry Hole _____

Abandoned _____

Date
JAN

6 1932

CHAS. L. SHERWOOD

192

Scout

no well

Returned	<i>BB</i>
Cards	
Tracing	<i>CRK</i>
France Map	<i>X</i>
Scarborough Map	<i>X</i>
Moody Map	<i>X</i>
Scarborough Flat Book	
Moody Flat Book	

Ellsworth

55
Map No. KANSAS Sec. 1 Twp. 17 R. 10 ^W

Well No. 2 Stratman

Aylward et al Company

Contractor

COMPLETE

SECTION PLAT

330 Ft. from N. Line

_____ Ft. from S. Line

_____ Ft. from E. Line

990 Ft. from W. Line

		o	

Location _____

Rig up _____

Drilling and Remarks:

*Swabbed 9 1/2 bls 1
Hour at 3775*

*Swabbed 10 1/2 bls
1 Hour at 3787.*

*Comp as no full 74
hour test will be made
at this time.*

RECORD

Cased _____ in., _____ ft.

Sand *Shiliceous: 3768-87*

Gas _____

Oil _____

Total Depth 3787

PRODUCTION

1st 24 hrs. Nat. _____

1st 24 hrs. after shot _____

Gas _____ Cu. Ft.

Dry Hole _____

Abandoned _____

Date

WAR 1 6 1932

CHAS. L. SHERWOOD

Scout

no well map

Returned	<i>ORH</i>
Cards	<i>ORH</i>
Tracing	<i>ORH</i>
France Map	<i>X</i>
Scarborough Map	<i>X</i>
Moody Map	<i>X</i>
Scarborough Plat Book	
Moody Plat Book	

Ellsworth

55

Map No. KAN. Sec. 1 Twp. 17 R. 10

Well No. 2 Stratman

Aylward & al Company

"Second" Contractor

SECTION PLAT

COMPLETED

		o	

330 Ft. from N. Line

~~110~~ Ft. from S. Line

~~110~~ Ft. from E. Line

990 Ft. from W. Line

Completed well

Location.....

Rig up.....

Drilling and Remarks:

Potential Prod
1918 Bes 24 Hours
on Pump

RECORD

Cased in., ft.

Sand Salicenus 3268-87

Gas.....

Oil.....

Total Depth 3287

PRODUCTION

1st 24 hrs. Nat.....

1st 24 hrs. after shot.....

Gas.....Cu. Ft.

Dry Hole.....

Abandoned.....

Date

March 31 1922

CHAS L. SHERWOOD

Scout

no wall

Returned
Cards
Tracing
France Map
Scarborough Map
Moody Map
Scarborough Plat Book
Moody Plat Book