


Ellsworth

Form 51-5M-11-31-Palace

Map No. **KANSAS** Sec. 11 Twp. 17 R. 10^w

Well No. 2-Stratman Farm
Robertson et al Company

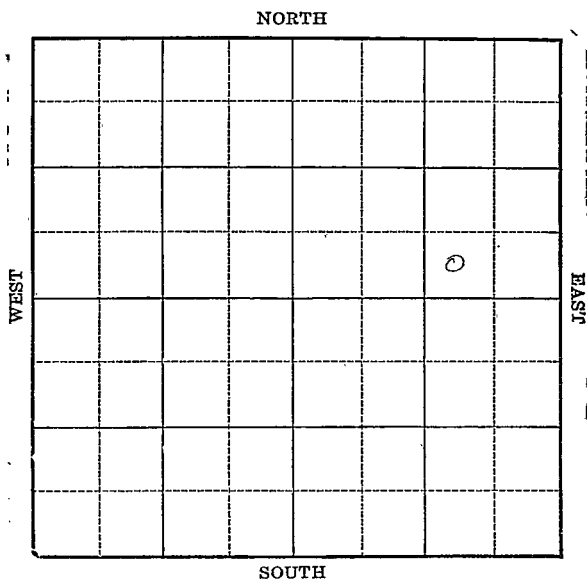

Location _____

Drilling Remarks _____

RECORD

Cased _____ in. _____ ft.

Sand _____

Gas _____

Oil _____

Total Depth _____

Rig Up _____

Drilling Remarks _____

PRODUCTION

1st 24 hrs. Nat. _____

1st 24 hrs. after shot _____

Gas _____ cu. ft.

Dry Hole _____

Abandoned _____




Ft. from N. Line

330 Ft. from S. Line

990 Ft. from E. Line

Ft. from W. Line

1932

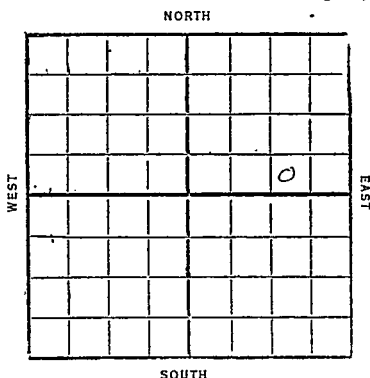

Date	REPORT
2/17	ROG.
2/26	
3/2	Run up
3/9	"20"-200'
	Spdg 750'
3/16	"2"-543
	Drlg 1240'
3/22	No report
3/30	"6"-2998
	Drlg 3045'
4/6	"6"-3267
	Silic lime 3267-73 1/2
	swab 325 bbl 3 1/2 hr
	pulling big pipe
4/13	T.D. 3273 1/2
	Run tubing and
	prep to take potential
4/20	Cased 6"-3267
	Silic lime 3267-73 1/2
	T.D. 3273 1/2
	Potential - 1970 bbl on pump
	Comp.

Ellsworth

55 KANSAS

Map No. _____ Sec. 1 Twp. 17 R. 10 WWell No. 2 StratmanRoberson & Co Company

Contractor

FIRST REPORTS

SECTION PLAT

_____ Ft. from N. Line

330 Ft. from S. Line990 Ft. from E. Line

_____ Ft. from W. Line

Location _____

Rig up Ro 4

Drilling and Remarks:

RECORD

Cased _____ in., _____ ft.

Sand _____

Gas _____

Oil _____

Total Depth _____

PRODUCTION

1st 24 hrs. Nat. _____

1st 24 hrs. after shot _____

Gas _____ Cu. Ft.

Dry Hole _____

Abandoned _____

Date

FEB 17 1932

CHAS. L. SHERWOOD

19

Scout

*no was
drawn*

Returned	
Cards	<i>TP</i>
Tracing	<i>2 3 4</i>
France Map	
Scarborough Map	
Moody Map	
Scarborough Plat Book	
Moody Plat Book	

Ellsworth

55

KANSAS

W

Map No. Sec. 1 Twp. 17 R. 10

Well No. 2 Blotman

Robertson & al Company

Contractor

COMPLETED


SECTION PLAT

.....Ft. from N. Line

330 Ft. from S. Line

990 Ft. from E. Line

.....Ft. from W. Line

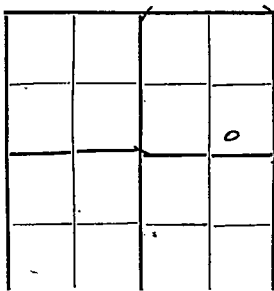

Location

Rig up

Drilling and Remarks:

Potential Prod
1970 Bls
on Pump

RECORD

Cased 6 in., 3267 ft.

Sand Silty cement 3267-73 1/2

Gas

Oil

Total Depth 3273 1/2

PRODUCTION.

1st 24 hrs. Nat.

1st 24 hrs. after shot

Gas Cu. Ft.

Dry Hole

Abandoned

Date

APR 20, 1932 CHAS. L. SHERWOOD

192

Scout

no trace

Returned	<i>[initials]</i>
Cards	<i>[initials]</i>
Tracing	<i>[initials]</i>
France Map	<i>[initials]</i>
Scarborough Map	<i>[initials]</i>
Moody Map	<i>[initials]</i>
Scarborough Flat Book	<i>[initials]</i>
Moody Flat Book	<i>[initials]</i>