

Ellsworth


Form 51-5M-2-29-34703

Map No. **KANSAS** Sec. 19 Twp. 17 R. 10^w

Well No. 3 Stratman Farm

Clyward et al Company

NORTH

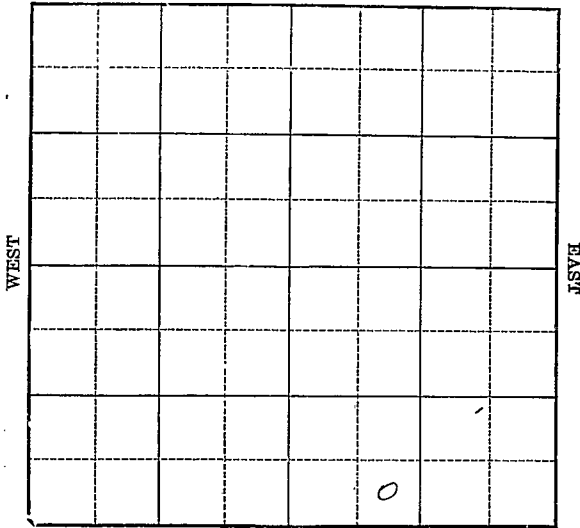

SOUTH

Location _____
Drilling Remarks _____

Rig Up _____
Drilling Remarks _____

RECORD


PRODUCTION

Cased _____ in. _____ ft.
Sand _____
Gas _____
Oil _____
Total Depth _____

1st 24 hrs. Nat. _____
1st 24 hrs. after shot _____
Gas _____ cu. ft.
Dry Hole _____
Abandoned _____

Map No. **KANSAS** Sec. 16 Twp. 17 R. 10^w
Well No. 3-Stratman Farm
Clyward et al Company

_____ Ft. from N. Line
330 Ft. from S. Line
_____ Ft. from E. Line
940 Ft. from W. Line
1932

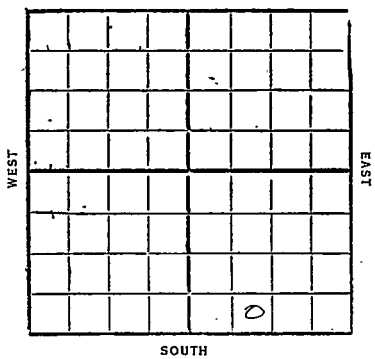

Date

REPORT

2/3	RA
2/10	—
2/17	—
2/26	—
3/2	—
3/9	—
3/16	Blkg rug
3/22	Blkg 300'
3/30	Blkg 900'
4/6	70"-1874
	Blkg 1965'
4/13	" 2620'
4/20	8"-2992
	6"-3161
	Blkg 3170
4/27	Top Blkg 3260-90
	3000' oil-in hole
	swab 95 bbls oil &
	swab down
	swab 4 1/2 bbl 3 hr - show
	water
	P.B. one pt-swab 12 bbl hr
	shot 40 at 3267-83
	Clay out

- 5/4 - T.D. 3290
P.B. to 3289
Png tubing.
- 5/11 - T.D. 3289 No. test
- 5/18 —
- 5/25 - T.D. 3289
Pump 42 bbl per hr
- 6/1 - Silic. lime 3260-90
T.D. 3290
P.B. one foot
shot 40 qt 3267-83
Est potential prod
1000 bbl on pump
Comp.

Ellsworth

55 KANSAS

Map No. _____ Sec. 1 Twp. 17 R. 10Well No. 3 StratmanAylward et al Company

Contractor

FIRST REPORTS

SECTION PLAT

_____ Ft. from N. Line

330 Ft. from S. Line

_____ Ft. from E. Line

990 Ft. from W. Line

Location _____

Roy

Rig up _____

Drilling and Remarks:

RECORD

Cased _____ in., _____ ft.

Sand _____

Gas _____

Oil _____

Total Depth _____

PRODUCTION

1st 24 hrs. Nat. _____

1st 24 hrs. after shot _____

Gas _____ Cu. Ft.

Dry Hole _____

Abandoned _____

Date
FEB

3 1932

19

CHAS. L. SHERWOOD

Scout

no wall road
Small

Returned	
Cards	
Tracing	OK
France Map	X
Scarborough Map	X
Moody Map	X
Scarborough Plat Book	
Moody Plat Book	

Ellsworth

55 KANSAS

Map No. _____ Sec. 1 Twp. 17 R. 10 ^W

Well No. 3 *Stratman*

Aylward *et al* _____ Company

_____ Contractor

COMPLETED

SECTION PLAT

_____ Ft. from N. Line

330 Ft. from S. Line

_____ Ft. from E. Line

990 Ft. from W. Line

Location _____

Rig up _____

Drilling and Remarks:

PB 1 Done
Shot 40/3267-83
Est Potential
Prod. 1000 Bbl
on pump

RECORD

Cased _____ in., _____ ft.

Sand *Siliceous 3260-90*

Gas _____

Oil _____

Total Depth 3290

PRODUCTION

1st 24 hrs. Nat. _____

1st 24 hrs. after shot _____

Gas _____ Cu. Ft.

Dry Hole _____

Abandoned _____

Date

JUN 1 1932

CHAS. L. SHERWOOD

no wall
Burr

Returned	
Cards	<i>JS</i>
Tracing	<i>CS</i>
France Map	<i>X</i>
Scarborough Map	<i>X</i>
Moody Map	<i>X</i>
Scarborough Plat Book	<i>X</i>
Moody Plat Book	