

Ellsworth


Form 51-5M-11-31-Palace

Map No. **KANSAS** Sec. 1 Twp. 17 R. 10^w

Well No. 4-Stratman Farm

Clyward Co. Company

NORTH

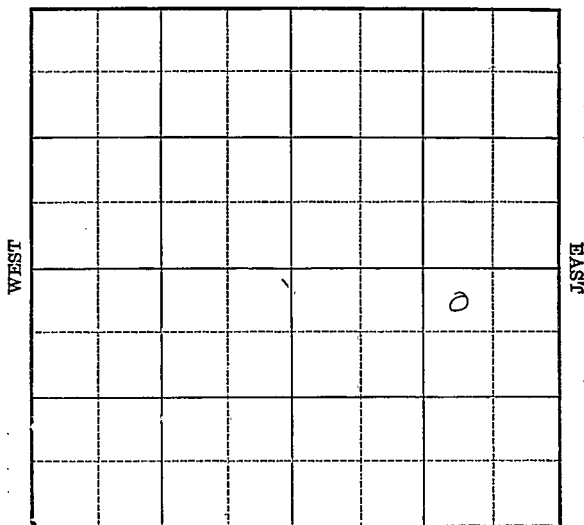

SOUTH

Location

Drilling Remarks

Rig Up

Drilling Remarks

RECORD

Cased _____ in. _____ ft.

Sand _____

Gas _____

Oil _____

Total Depth _____

PRODUCTION

1st 24 hrs. Nat. _____

1st 24 hrs. after shot _____


Gas _____ cu. ft.

Dry Hole _____

Abandoned _____

Map No. KANSAS Sec. 1 Twp. 17 R. 10^W
Well No. 4 - Stratman Farm
Cylward et al Company

NORTH

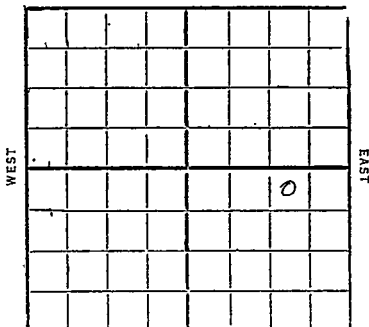

330 Ft. from N. Line

_____ Ft. from S. Line

990 Ft. from E. Line

_____ Ft. from W. Line

1932

SOUTH

Date

REPORT

3/2	Bldg reg
3/9	Rig up
3/16	Dreg 390'
3/22	" 1700'
3/30	" 2475'
4/6	HFW 3015
	8"-3025
	Dreg 3055'
4/13	Top Conglomerate 3210-35
	6"-3253
	Top Silic lime 3254
	Core 3256-61
	T.D. 3261
	swab 90 bbl 2 1/2 hrs
4/20	T.D. 3261
	No test
	Prep to pump
4/27	T.D. 3261
	Pump 944 bbl. 9 1/2 hrs
	(over)

5/4. Cased 6"-3253
Silic lime 3254-61
Pay 3256-61
TD 3261
Potential prod
2392 bbls oil
Comp.

Ellsworth

55 KANSAS

Map No. _____ Sec. 1 Twp. 17 R. 10 WWell No. 4 StratmanAgnew & Co Company

Contractor

FIRST REPORTS

SECTION PLAT

330 Ft. from N. Line

_____ Ft. from S. Line

990 Ft. from E. Line

_____ Ft. from W. Line

			0

Location _____

Rig up _____

Drilling and Remarks:

Blay Rig

RECORD

Cased _____ in., _____ ft.

Sand _____

Gas _____

Oil _____

Total Depth _____

PRODUCTION

1st 24 hrs. Nat. _____

1st 24 hrs. after shot _____

Gas _____ Cu. Ft.

Dry Hole _____

Abandoned _____

Date

MAR

2 1932

CHAS. L. SHERWOOD

19

Scout

*no well
all*

Returned	<i>JP</i>
Cards	<i>JP</i>
Tracing	<i>JP</i>
France Map	<i>X</i>
Scarborough Map	<i>X</i>
Moody Map	<i>X</i>
Scarborough Plat Book	
Moody Plat Book	

55 KANSAS

Map No. _____ Sec. 1 Twp. 17 R. 10 ^WWell No. 4 StratmanAylward Oil & Hl Company

Contractor _____

COMPLETED


330 Ft. from N. Line

_____ Ft. from S. Line

990 Ft. from E. Line

_____ Ft. from W. Line

SECTION PLAT

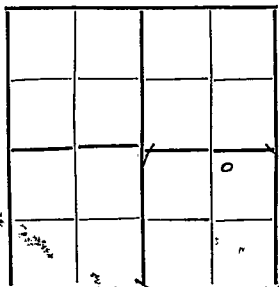

Location _____

Rig up _____

Drilling and Remarks: _____

Pay 3256-61Potential Prod
2392 Bbl.

RECORD

Cased 6 in., 3253 Ft.Sand Oil case 3256-61

Gas _____

Oil _____

Total Depth 3261

PRODUCTION

1st 24 hrs. Nat. _____

1st 24 hrs. after shot _____

Gas _____ Cu. Ft.

Dry Hole _____

Abandoned _____

Date

MAY 4 1932

CHAS. L. SHERWOOD

192

Scout

no was
meat not

Returned	
Cards	
Tracing	
France Map	X
Scarborough Map	X
Moody Map	X
Scarborough Plot Book	
Moody Plot Book	