


Ellewoith

Form 252-A
5M 4-32 MPC

Map No. KANSAS Sec. 1 Twp 17 R. 10^W

Well No. 4 Stretman Farm
Sinclair - Prairie Company

990 Ft. from N. Line
 Ft. from S. Line
330 Ft. from E. Line
 Ft. from W. Line

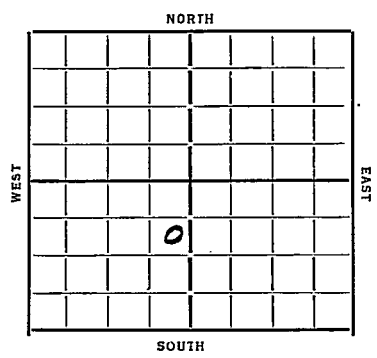

Date 1934

REPORT

6/13
6/21
6/28
7/5
7/12
7/19
7/26
8/9
8/16
8/23
8/30
9/6
9/13
9/20
9/26

Rig

Rign up
Dly 360 15 1/2 347
" 1290 12 1/2 525
7 sq 1665
8/2
Dly 1880
" 2390 6" 2244
" 3045
6" 3062 S.O. 3095 - 3100
Oil ³²⁴⁴ ~~3249~~ T 3251 W.R. 5"
2000' oil
6" W.R. to 3249
T Siliceous 3244 Corrected
T 3258 Swab 30 Bbls per hr
acidizing
No test
Siliceous 3244 T 3258
1000 acid 585 Bbls.

COMPLETED

Map No. 55 Sec. 1 Twp. 17 R. 10W

Well No. 4 - Stratman
Archer - Prairie Company

Contractor

FIRST REPORT

SECTION PLAT

990 Ft. from N. Line
 _____ Ft. from S. Line
330 Ft. from E. Line
 _____ Ft. from W. Line

Location _____

Rig up _____

Drilling and Remarks:

Rig

RECORD

Cased _____ in., _____ ft.
 Sand _____
 Gas _____
 Oil _____
 Total Depth _____

PRODUCTION


1st 24 hrs. Nat. _____
 1st 24 hrs. after shot _____
 Gas _____ Cu. Ft.
 Dry Hole _____
 Abandoned _____

ORVAL MANNSCHECK

Date

6-13-34 19

Scout

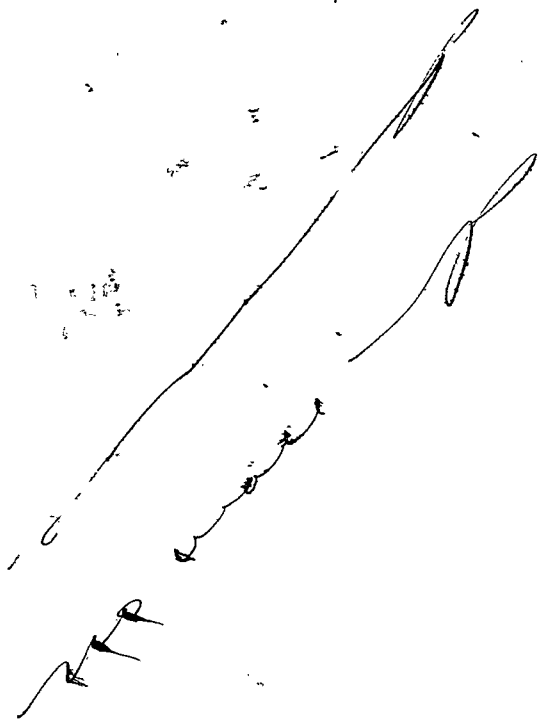

Returned	<i>RS</i>
Cards	<i>RS</i>
Tracing	<i>nvt</i>
Franco Map	<i>nvt</i>
Col. French Map	
Mod. Map	
Starb. Map	
Brooklyn	

Ellsworth

Form 28-1M Bks. 2-29

Map No. 55 Sec. 1 Twp. 17 R. 10W

Well No. 4 - Stratman

Sinclair - Prairie Company

~~CONDENSED~~ Contractor

SECTION PLAT

		0	

990 Ft. from N. Line

_____ Ft. from S. Line

330 Ft. from E. Line

_____ Ft. from W. Line

Location _____

Rig up _____

Drilling and Remarks:

1000 acid

585 bbls

RECORD

Cased _____ in., _____ ft.

Sand silicious 324 1/2

Gas _____

Oil _____

Total Depth 3258

PRODUCTION

1st 24 hrs. Nat. _____

1st 24 hrs. after shot _____

Gas _____ Cu. Ft.

Dry Hole _____

Abandoned _____

Date

9-26-34 19

ORVAL MANNSCHRECK
Scout

no value
see

Returned	
Cards	RF
Trans	RF
REC	X
SA	X
MO	X
SS	X
I	X

