


Well No. 3 - Stratman Farm
Aylward et al Company
 NORTH

-NORTH

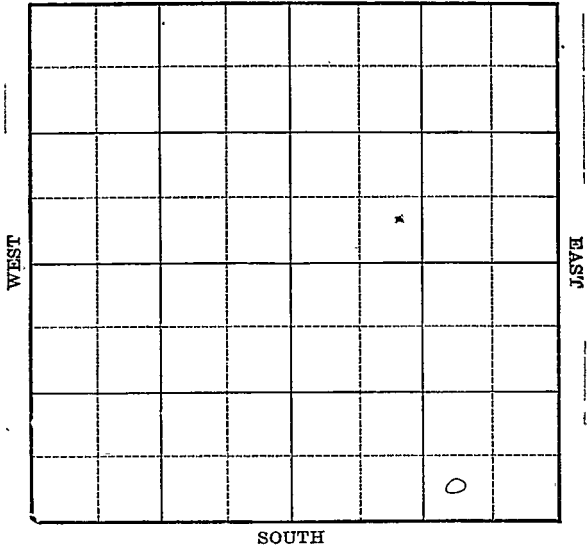

Location_____

Drilling Remarks

Rig Up

Drilling Remarks

RECORD

Cased _____ in. _____ ft.

Sand_____

Gas

Oil

Total Depth_____

PRODUCTION

1st 24 hrs. Nat.-----

1st 24 hrs. after shot-----

Gas -----cu. ft.-----

Dry Hole_____

Abandoned_____


Map No. KANSAS Sec. 1 Twp. 17 R. 10^W
Well No. 5- Stratman Farm
Upward et al. Company

 Ft. from N. Line

330 Ft. from S. Line

990 Ft. from E. Line

1932 Ft. from W. Line

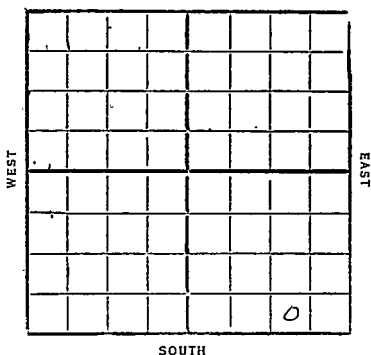

Date

REPORT

4/13	ROG
4/20	—
4/27	—
5/4	—
5/11	f
5/18	27dg 100'
5/25	15" 305
	12" 520
	Drilg 860'
6/1	10" 1848
	Drilg 1950'
6/8	" 2770'
6/15	Top Cong 3205
	6" 3235
	Julic lime 3238-45
	swab 50 bbl per hr
	drilg 3249
6/22	TID 3249 Rng tubing.
	To take potential
6/29	TID 3249 No test
	(Over)

7/6- Cased 6"-3235
Land 3238-49
T.D. 3249
Potential prod
2198 bbl oil
Comp.

55 KANSAS

Map No. _____ Sec. 1 Twp. 17 R. 10 ^WWell No. 5 StratmanAylward et al Company

Contractor

FIRST REPORTS

_____ Ft. from N. Line

330 Ft. from S. Line990 Ft. from E. Line

_____ Ft. from W. Line

SECTION PLAT

			0

Location _____

Rig up _____

Drilling and Remarks:

Progs.

RECORD

Cased _____ in., _____ ft.

Sand _____

Gas _____

Oil _____

Total Depth _____

PRODUCTION

1st 24 hrs. Nat. _____

1st 24 hrs. after shot _____

Gas _____ Cu. Ft.

Dry Hole _____

Abandoned _____

Date

APR 13 1932

192 CHAS. L. SHERWOOD

Scout

no wall

small moat

Re.	
Ce.	
Tracing	
France Map	
Scarborough Map	X
Moody Map	X
Scarborough Plat Book	
Moody Plat Book	

Ellsworth
55 KANSAS

Map No. _____ Sec. 1 Twp. 17 R. 10 ^W

Well No. 5 *Stratman*

Aylward & Co _____ Company

_____ Contractor

COMPLETED

SECTION PLAT

_____ Ft. from N. Line

330 Ft. from S. Line

990 Ft. from E. Line

_____ Ft. from W. Line

			0

Location _____

Rig up _____

Drilling and Remarks: _____

RECORD

Cased 6 in. 3235 ft.

Sand 3238-3249

Gas _____

Oil _____

Total Depth 3249

PRODUCTION

1st 24 hrs. Nat. _____

1st 24 hrs. after shot _____

Gas _____ Cu. Ft.

Dry Hole _____

Abandoned _____

Date

JUL 6 1932 **CHAS. L. SHERWOOD**

192

Scout

Potential Prod
2198 Bbls

no more

Returned.....	<i>[Signature]</i>
Cards.....	<i>[Signature]</i>
Tracing.....	<i>[Signature]</i>
France Map.....	X
Scarborough Map.....	X
Moody Map.....	X
Scarborough Plat Book.....	X
Moody Plat Book.....	