


Map No. KANSAS Sec. 1 Twp. 17 R. 10^w

Well No. 1- Stratman Farm
Prairie Oil & Gas Company

990 Ft. from N. Line
 Ft. from S. Line
990 Ft. from E. Line
 Ft. from W. Line

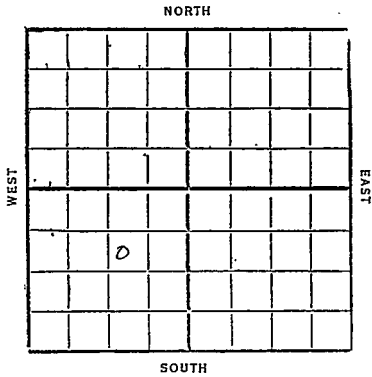

1932

Date	REPORT
2/17	ROG.
2/26	
3/2	Drain up
3/9	Drlog 285'
3/16	Drlog 865'
3/22	" 1700'
3/30	" 2675'
4/6	show oil, gas & water at 3098'
	show oil 3090-3100 8"-3057
	Drlog 3168'
4/9	Top Celtic line 3258 (subject to correction) set 6 5/8" - 3259
	show oil at 3282-85 75' oil in hole
	Drlog 3328' line
	No increase oil or water
4/13	2500' water 3323-28 S.D. 3328' TD.
	Well plug back & shoot

4/20 - T.D. 3328
P.B. to 3303
shot 120 qt 3270-3303
swab 104 bbl' 14 hrs
S.D. 14 hours
swab 42 bbls oil
and 6 bbls water

4/27 - Cured 6"-3259
Culic lime 3258-3328
show oil 3282-85
2500' sul water 3323-28
T.D. 3328
P.B. to 3303
shot 120 qt 3270-3303
Pump 61 bbls oil
and 10 " water
Comp.

Ellsworth

55

Map No. **KANSAS** Sec. 1 Twp. 17 R. 10 ^W


Well No. 1 *Stratman*

Prairie Oil & Gas Co Company
Contractor

FIRST REPORTS

990 Ft. from N. Line
_____ Ft. from S. Line
990 Ft. from E. Line
_____ Ft. from W. Line

SECTION PLAT

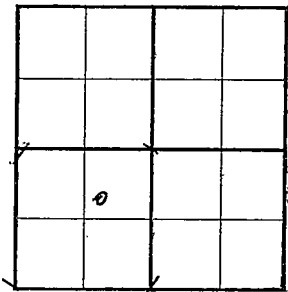

Location _____

Rig up *Pro S*

Drilling and Remarks:

RECORD

Cased _____ in., _____ ft.
Sand _____
Gas _____
Oil _____
Total Depth _____

PRODUCTION

1st 24 hrs. Nat. _____
1st 24 hrs. after shot _____
Gas _____ Cu. Ft.
Dry Hole _____
Abandoned _____

Date
FEB 17 1932

CHAS. L. SHERWOOD

19

Scout

Ellsworth

55

KANSAS

Map No. Sec. 1 Twp. 17 R. 10

Well No. 1; Stratman

Prairie Oil & Gas Co. Company

Contractor

COMPLETED

990 Ft. from N. Line

Ft. from S. Line

990 Ft. from E. Line

Ft. from W. Line

SECTION PLAT

Location

Rig up

Drilling and Remarks:

Show Oil 3x8x85
2500 Sulphur Water
3323-28, PB 20
3303

Shot 120/3270-3303

Pump 61 Bls. Oil
10 Bls. Water

RECORD

Cased 6 in., 3259 ft.

Sand Oil casing 3258-3328

Gas

Oil

Total Depth 3328

PRODUCTION

1st 24 hrs. Nat.

1st 24 hrs. after shot

Gas Cu. Ft.

Dry Hole

Abandoned

Date

APR 27 1932

CHAS. L. SHERWOOD