

Map No. KANSAS Sec. 11 Twp. 11 R. 12

Well No. 1-Edelman Farm

NORTH

WEST

EAST

SOUTH

Location

Drilling Remarks

Rig Up.

Drilling Remarks

RECORD

Cased _____ in. _____ ft.

Sand

Gas

Oil _____

Total Depth_____

PRODUCTION

1st 24 hrs. Nat.-----

1st 24 hrs. after shot_____

Gas _____ cu. ft. _____

Dry Hole_____

Abandoned_____

Map No. **KANSAS** Sec. 1 Twp. 17 R. 10^w

Well No. 1-Stratman Farm
J A Aylward et al Company

NORTH

990 Ft. from N. Line


_____ Ft. from S. Line

_____ Ft. from E. Line

990 Ft. from W. Line

1930

WEST

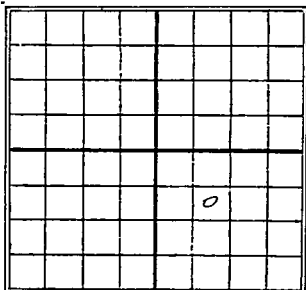

EAST

SOUTH

Date

REPORT

11/25	LOG
12/3	Ray & Tools
12/10	W. P. water well
12/17	—
12/23	Running up
12/30	Spud 1
1/3	—
1/17	—
1/14	Spud & SD
1/21	—
1/28	—
2/4	—
2/11	UPR 15"-320'
2/18	Dreg 610'
2/25	FD 610' Oly out
3/4	Dreg 1690'
3/11	10"-1835
	dreg 2007
3/18	" " 2800'
	(over)

3/26- Top Silc line 3260
T.D. 3260- 6"- 3181
filled up 1000' oil
in one hour at T.D.
Now have 2800' of oil
Graw 47 at 72°
Bldg tankage
set 180 ft 5" liner at 3255

4/8- Top Silc line 3255'
T.D. 3260'
swab 152 bbl oil
in 3 hrs yesterday
swab 37 1/2 bbls 4th hr
" 25 " 5th "
deepened 6 ft
T.D. 3266'
swab 90 bbl 3/4 hr.
1200' off bottom
2 hours after deepening
made 57 bbl this P.M.
700 ft off bottom
deepening did not help
May deepen

4/9- Shale break 3266-68
Best pay 3268-71
T.D. 3271 soft Silc. line
swab 90 bbl 1st hour
" 117 1/2 " 2nd "
Could lower fluid
only 900' from top of pipe
Pulling pipe
Now shut in
Graw 47 at 72°

Map No. KANSAS Sec. 1 Twp. 17 R. 10^w

Well No. 1-Stratman Farm
J.A. Aylward et al Company

NORTH


990 Ft. from N. Line

_____ Ft. from S. Line

_____ Ft. from E. Line

990 Ft. from W. Line

1931

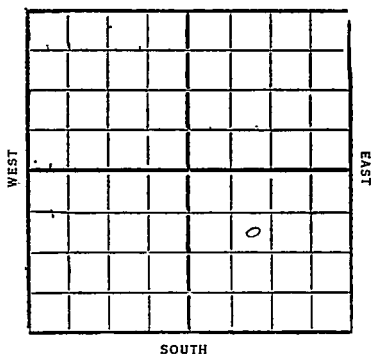

Date

REPORT

4/15

Sand 3255-71
Shale break 3266-68
T.D. 3271
swab 90 fpl 1st hour
" 117 1/2 " 2nd "
Shut in
Draw. 47 1/2 at 72°
Comp.

Map No. **KANSAS** Sec. 1 Twp. 17 R. 18W
 55
 Well No. 1 Stratman

J. A. Cyward & Co. Company
 Contractor

SECTION PLAT

990 Ft. from N. Line

..... Ft. from S. Line

..... Ft. from E. Line

990 Ft. from W. Line

FIRST REPORTS

Location.....

Rig up.....

Drilling and Remarks:

ROY

RECORD

Cased.....in.,ft.

Sand.....

Gas.....

Oil.....

Total Depth.....

PRODUCTION

1st 24 hrs. Nat.....

1st 24 hrs. after shot.....

Gas.....Cu. Ft.

Dry Hole.....

Abandoned.....

Date

NOV 25 1930

S. J. LEWIS Scout

55 **KANSAS** Sec. 1 Twp. 17 R. 10 ^W

Well No. 1 Stratman

J. A. Aylward et al Company

Contractor

COMPLETE

990 Ft. from N. Line

_____ Ft. from S. Line

_____ Ft. from E. Line

990 Ft. from W. Line

SECTION PLAT

Location _____

Rig up _____

Drilling and Remarks:

Shale Break
3866-68
Log 90 lbs 1st hour
" 117 1/2 " 2nd hour
Shut in.
47.2 gravity at 72

RECORD

Cased _____ in., _____ ft.

Sand 3255-3271

Gas _____

Oil _____

Total Depth 3271

PRODUCTION

1st 24 hrs. Nat. _____

1st 24 hrs. after shot _____

Gas _____ Cu. Ft.

Dry Hole _____

Abandoned _____

Date

APR 15 1931

192 **CHAS. L. SHERWOOD**

Scout