

NORTH

WEST

		○			

EAST

SOUTH

Rig Up_____

Drilling Remarks

PRODUCTION

1st 24 hrs. Nat.-----

1st 24 hrs. after shot_____

Gas _____ cu. ft. _____

Dry Hole_____

Abandoned_____

Ellsworth

Map No. **KANSAS** Sec. 1 Twp. 17 R. 10 W


Well No. 1 Stratman Farm
Joe Ellsworth Company

Ft. from N. Line

330 Ft. from S. Line

330 Ft. from E. Line

Ft. from W. Line

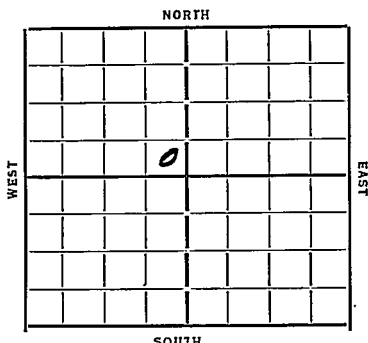

Date 7/23/54 REPORT

9/26 Rig
10/4 Dlg 655 15" 360 12 1/2 535
10/11 " 1870
10/18 " 2560 10" 1870
10/25 6" 3104 A.O. 3020-30
T Lansing 2905 Dlg 3150
11/1 Silicious 3242 A.O. 3245
11/8 HFW 3283-88 PB 3278
40 qt shot CO
11/14 Silicious 3242
T1) 3288 1) r A

ABANDONED

KANSAS

Map No. 55 Sec. 1 Twp. 17 R. 10 ^W

Well No. 1-Stratman

Joe Alward Company

Contractor

SECTION PLAT

 Ft. from N. Line

330 Ft. from S. Line

330 Ft. from E. Line

 Ft. from W. Line

FIRST REPORTS

Location

Rig up

Drilling and Remarks:

Rig

RECORD

Cased in., ft.

Sand

Gas

Oil

Total Depth

PRODUCTION

1st 24 hrs. Nat.

1st 24 hrs. after shot

Gas Cu. Ft.

Dry Hole

Abandoned

Date

9-26-37 19

ORVAL MANNSCHRECK

Scout

Map No. 55 Sec. 1 Twp. 17 R. 10WWell No. 1-StratmanGre Alyward Company

Contractor

ABANDONED

SECTION PLAT

	0		

Ft. from N. Line

330 Ft. from S. Line330 Ft. from E. Line

Ft. from W. Line

Location

Rig up

Drilling and Remarks:

10 + H

RECORD

Cased in, ft.

Sand silicous 3242

Gas

Oil

Total Depth 32880

PRODUCTION

1st 24 hrs. Nat.

1st 24 hrs. after shot

Gas Cu. Ft.

Dry Hole

Abandoned

Date

ORVAL MANNSCHRECK

11-14-34 192

Scout