


Ellsworth

Form 51-5M-2-29-34703

Map No. **KANSAS** Sec. Twp. 17 R. 10w

Well No. 1-Stratman Farm
Robertson et al Company

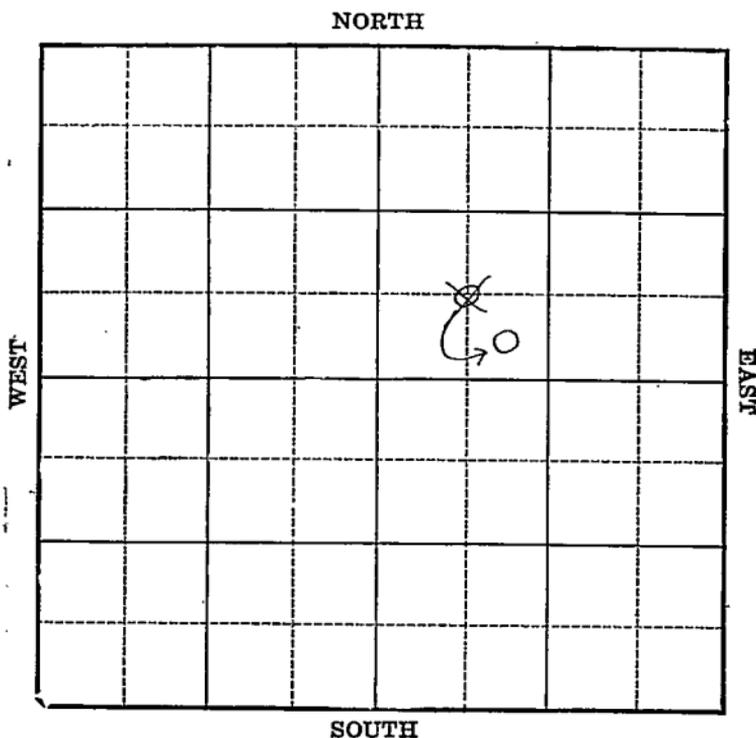

Location _____

Drilling Remarks _____

RECORD

Cased _____ in. _____ ft.

Sand _____

Gas _____

Oil _____

Total Depth _____

Rig Up _____

Drilling Remarks _____

PRODUCTION

1st 24 hrs. Nat. _____

1st 24 hrs. after shot _____

Gas _____ cu. ft.

Dry Hole _____

Abandoned _____


Ellsworth

FORM 252A-5M-8-30-PETROL

Map No. **KANSAS** Sec. 1 Twp. 17 R. 10^w

Well No. 1-Stratman Farm
Robertson et al. Company

330 Ft. from N. Line
~~660~~ Ft. from S. Line
990 Ft. from E. Line
~~660~~ Ft. from W. Line

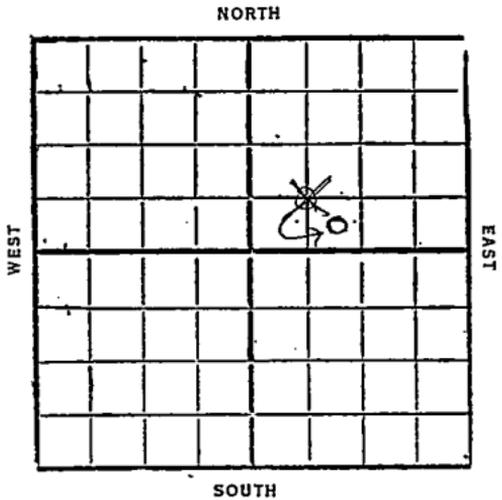

1931

Date	REPORT
11/10	ROS
11/18	—
11/24	—
12/2	—
12/19	—
12/16	—
12/22	Spdg
12/30	Drilg 15 1/2" - 372 Drilg 1060'
1932	
1/7	" 1855'
1/13	" 2350'
1/20	8" - 2870 Drilg 2930'
1/27	Gas 2975-80 Increase 3024-30 3045'
	Est. total 4 1/2 gas NIR 8" - 3060'
1/29	Landed 8" - 3065' drilg 3100' (over)

2/1- Siliceous lime 3268-6"-3268'
TD 3272 - Hole full oil -
Filled up 1500 feet in 30
minutes (Telegram)

2/2- TD 3275' Siliceous lime
Hole full oil 11 hrs
Prep. to swab

2/9- TD 3277½'
swab 90 bbl in 1 hr test
swabbing from the
1500 foot level
Well run tubing

2/17- Cased 6"-3268'
Siliceous 3268-77½'
TD 3277½'
Potential prod
1240 bbl
Comp

Ellsworth

55 KANSAS Map No. Sec. 1 Twp. 17 R. 10^W

Well No. 1 Stratman
Robertson et al Company

Contractor

FIRST REPORTS

SECTION PLAT

..... Ft. from N. Line
660 Ft. from S. Line
..... Ft. from E. Line
660 Ft. from W. Line

		o	

Location.....
R 0 4
Rig up.....
Drilling and Remarks:.....

RECORD

Cased..... in., ft.
Sand.....
Gas.....
Oil.....
Total Depth.....

PRODUCTION

1st 24 hrs. Nat.....
1st 24 hrs. after shot.....
Gas..... Cu. Ft.
Dry Hole.....
Abandoned.....

Date

NOV 1 0 1931

192 CHAS. L. SHERWOOD Scout

Ellsworth

55 KANSAS

Map No. _____ Sec. 1 Twp. 17 R. 10 W

Well No. 1 *Stratman*

Robertson et al Company

Contractor

CORRECTION

_____ Ft. from N. Line

330 Ft. from S. Line

_____ Ft. from E. Line

990 Ft. from W. Line

Corrected from

C-SW-NE to SE-SW-NE

SECTION PLAT

		0	

Location _____

Rig up _____

Drilling and Remarks:

Spool

Chg location to above

RECORD

Cased _____ in., _____ ft.

Sand _____

Gas _____

Oil _____

Total Depth: _____

PRODUCTION

1st 24 hrs. Nat. _____

1st 24 hrs. after shot _____

Gas _____ Cu. Ft.

Dry Hole _____

Abandoned _____

Date

DEC 22 1931

CHAS. L. SHERWOOD

192 Scout

Ellsworth

55 KAN

Map No. _____ Sec. 1 Twp. 17 R. 10 W

Well No. 1 Stratman

Roberts & al Company

Contractor

COMPLETE

SECTION PLAT

_____ Ft. from N. Line

330 Ft. from S. Line

_____ Ft. from E. Line

990 Ft. from W. Line

		o	

Location _____

Rig up _____

Drilling and Remarks:

Potential Prod
1240 Blo.

RECORD

Cased 6 in., 3268 ft.

Sand Siliceous 3268-775

Gas _____

Oil _____

Total Depth 3277 1/2

PRODUCTION

1st 24 hrs. Nat. _____

1st 24 hrs. after shot _____

Gas _____ Cu. Ft.

Dry Hole _____

Abandoned _____

Date

FEB 1 1932

19

CHAS. L. SHERWOOD

Scout