

Map No. KANSAS Sec. 1 Twp. 11 R. 10

Well No. d-Williams Farm

TEST

FAST

SOUTH

Location

Drilling Remarks

Rig Up_____

Drilling Remarks

Cased _____ in. _____ ft.

Sand

Gas _____

Oil _____

Total Depth

1st 24 hrs. Nat.-----

1st 24 hrs. after shot.....


Gas_____cu. ft._____

Dry Hole_____

Abandoned_____

Map No. KANSAS Sec. 1 Twp. 17 R. 10^W
Well No. 2 - Stratzman Farm
Linclair - Prairie Company

NORTH

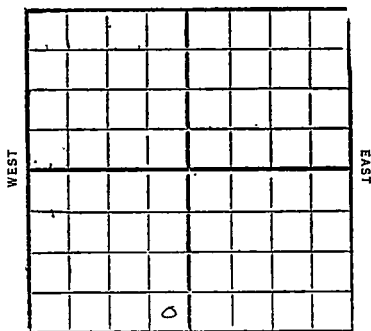

 Ft. from N. Line

330 Ft. from S. Line

330 Ft. from E. Line

 Ft. from W. Line

SOUTH

1932

Date

REPORT

11/16	Doc
11/23	Pond
11/30	
12/7	Aug
12/14	
12/21	Aug 17
12/28	15" 320'
1933	
1/4	12" 517
	Dreg 970'
1/11	10" 1850
	Dreg 1880
1/18	" 2385'
1/25	8" 2897
	Dreg 2950'
2/1	8" 3043
	Small show oil 3085
	1 barrel water 3140-50
	Top Cong 3225
	Small show oil 3244
	Rng 6" csg
	(over)

2/8- Top Siliceous 3244
TD 3271
swab 95 bbl 10 hr

2/15- TD 3271
PB to 3270
swab 3 to 4 bbl per hour
Will shoot 20 qt 3264-70

2/22- (P.B. to 3270)
shot 20 qt 3264-70
swab 240 bbl 18 hrs
Water broke in
Perm 6" csg

3/4 Cleaning out

3/8 6"- 3244'
Sand 3244- 3271' - J.D.
P.B. to 3070'
shot 20 qt 3264-70'
Pump 150 bbls 24 hrs
Completed

Ellsworth

W

55 KANSAS

Map No. _____ Sec. 1 Twp. 17 R. 10

Well No. 2 Stratman

Linclair Prairie Company

Contractor

FIRST REPORTS

SECTION PLAT

_____ Ft. from N. Line

330 Ft. from S. Line

330 Ft. from E. Line

_____ Ft. from W. Line

Location _____

Rig up _____

Drilling and Remarks:

RECORD

Cased _____ in., _____ ft.

Sand _____

Gas _____

Oil _____

Total Depth _____

PRODUCTION

1st 24 hrs. Nat. _____

1st 24 hrs. after shot _____

Gas _____ Cu. Ft.

Dry Hole _____

Abandoned _____

Date

NOV 13 1932 CHAS. L. SHERWOOD

Scout

55 KANSAS

Map No. Sec. 1 Twp. 17 R. 10 W

Well No. 2 Stratman

Sinclair - Prairie Company

Contractor

COMPLETED

Ft. from N. Line

330 Ft. from S. Line

330 Ft. from E. Line

Ft. from W. Line

SECTION PLAT

Location

Rig up

Drilling and Remarks:

P.B. to 3270

Shot 20/3264-70

Pump 150 Bbls

24 Hours

RECORD

Cased 4 in., 3244 ft.

Sand 3244-3271

Gas

Oil

Total Depth 3271

PRODUCTION

1st 24 hrs. Nat.

1st 24 hrs. after shot

Gas Cu. Ft.

Dry Hole

Abandoned

Date

MAR 8 1933

CHAS. L. SHERWOOD

192

Scout