


KANSAS

Ellsworth

Form 51-5M-11-31-Palace

Map No. _____ Sec. 1 Twp. 17 R. 10WWell No. 7-Stratman Farm
Alyward et al Company

NORTH

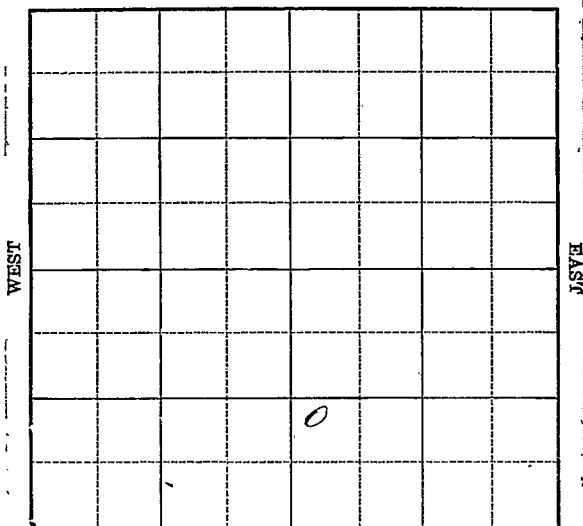

SOUTH

Location _____

Drilling Remarks _____

Rig Up _____

Drilling Remarks _____

RECORD

Cased _____ in. _____ ft.

Sand _____

Gas _____

Oil _____

Total Depth _____

PRODUCTION

1st 24 hrs. Nat. _____

1st 24 hrs. after shot _____

Gas _____ cu. ft. _____

Dry Hole _____

Abandoned _____

Ellsworth


KANSAS

Form 252-A
5M 4-32 MPCMap No. _____ Sec. 1 Twp. 17 R. 10WWell No. #7 Stratman Farm
Alward et al Company

_____ Ft. from N. Line

990 Ft. from S. Line

_____ Ft. from E. Line

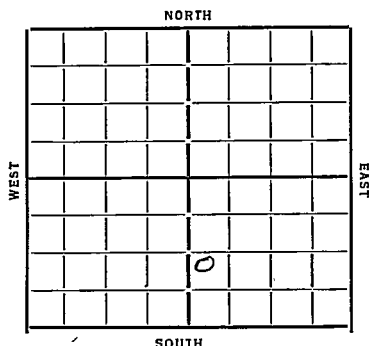330 Ft. from W. LineDate
1933

REPORT

7/19 location

7/26 Rig

8/2 Rig up

8/19 15" 325 - 12" 535' Drly 675'

8/16 Drly 1785'

8/23 " 2120'

8/30 " 2360'

9/6 8" at 3030 - 10 reg 3150

9/13 20p Sib 3246 - T 10 3263 - Swab

8 bbls per hr - Shot 30 gals - C. O

9/20 3261 - 63 swab 43 bbls R. Cement 5" 3243

9/29

10/5 swab 32 bbls per hr

10/11 25' 4" Liner 3263 - Swab 29

bbls per hr - 8% water

10/18 — 10/25 — 11/1 — 11/8 —

11/5 Silicovar 3246 - 63 T.D.

400' bbls COMPLETED

KANSAS

Map No. 55 Sec. 1 Twp. 17 R. 10W

Well No. #7 Stratman

Alward et al Company

Contractor

SECTION PLAT

Ft. from N. Line

990 Ft. from S. Line

Ft. from E. Line

330 Ft. from W. Line

Location ☒

Rig up

Drilling and Remarks:

RECORD

Cased.....in.,ft.

Sand.....

Gas.....

Oil.....

Total Depth.....

PRODUCTION

1st 24 hrs. Nat.....

1st 24 hrs. after shot.....

Gas.....Cu. Ft.

Dry Hole.....

Abandoned.....

Date

7/19/33 192 Oval Manchester Scout

Map No. 55 Sec. 1 Twp. 17 R. 10W

Well No. 7 - Stratman

Alyward et al Company

Contractor

SECTION PLAT

Ft. from N. Line

990 Ft. from S. Line

Ft. from E. Line

330 Ft. from W. Line

COMPLETED

Location

Rig up

Drilling and Remarks:

400 bbls

RECORD

Cased in, ft.

Sand siliceous 3246

Gas

Oil

Total Depth 3263

PRODUCTION

1st 24 hrs. Nat.

1st 24 hrs. after shot

Gas Cu. Ft.

Dry Hole

Abandoned

Date

11-15-33 192 O. W. Mannschied Scout