


Ellsworth

Form 51-5M-11-31-Palace

M.p. No. KANSAS Sec. 1 Twp. 17 R. 10W

Well No. 8 Stratman Farm

Alyward et al Company

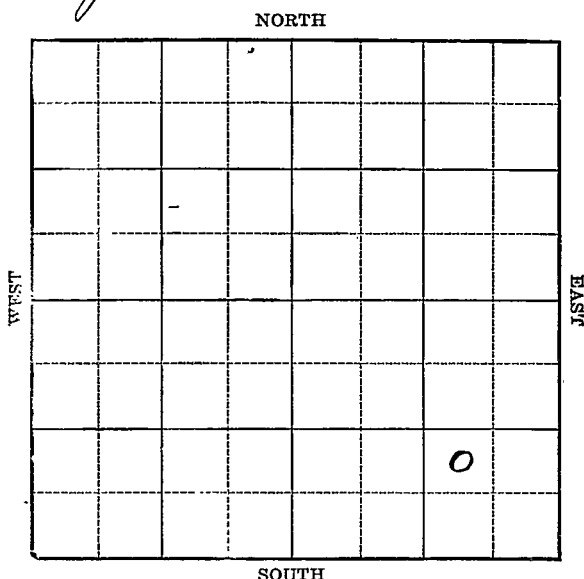

Location _____

Drilling Remarks _____

RECORD

Cased _____ in. _____ ft.

Sand _____

Gas _____

Oil _____

Total Depth _____

Rig Up _____

Drilling Remarks _____

PRODUCTION

1st 24 hrs. Nat. _____

1st 24 hrs. after shot _____

Gas _____ cu. ft.

Dry Hole _____

Abandoned _____

Ellsworth

Map No. KANSAS Sec. 1 Twp. 17 R. 10W

Well No. 8 Stetman Farm


Alyward et al Company

 Ft. from N. Line

990 Ft. from S. Line

990 Ft. from E. Line

 Ft. from W. Line

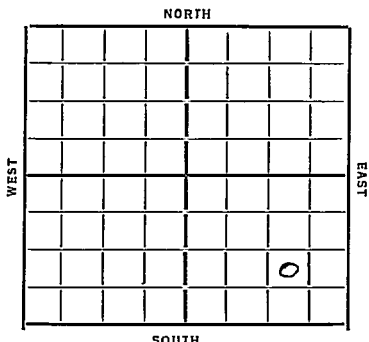

Date 1934

REPORT

3/28 Cellar
4/5 — 4/12 —
4/19 Spud
4/26 Dlg 845 20" 40 15" 348 12" 524
5/3 " 1885
5/10 Dlg 2715 10" 1855
5/18 " 3210 8" 3035 6" 3180
5/23 Siliceous 3243 TD 3257 D+H

ABANDONED

Map No. 55 Sec. 1 Twp. 17 R. 10WWell No. 8 - StratmanAlward et al Company

Contractor

FIRST REPORTS**SECTION PLAT**

Ft. from N. Line

990 Ft. from S. Line990 Ft. from E. Line

Ft. from W. Line

Location

Rig up

Drilling and Remarks:

cellar**RECORD**

Cased in., ft.

Sand

Gas

Oil

Total Depth

PRODUCTION

1st 24 hrs. Nat.

1st 24 hrs. after shot

Gas Cu. Ft.

Dry Hole

Abandoned

Date

3-28-34

192

Scout

KANSAS

Map No. 55 Sec. 1 Twp. 17 R. 10WWell No. 8-StratmanEdward et al Company

Contractor

SECTION PLAT

			0

ABANDONED

Ft. from N. Line

990 Ft. from S. Line990 Ft. from E. Line

Ft. from W. Line

Location _____

Rig up _____

Drilling and Remarks:

O A H

RECORD

Cased _____ in., _____ ft.

Sand silicious 3243

Gas _____

Oil _____

Total Depth 3257

PRODUCTION

1st 24 hrs. Nat. _____

1st 24 hrs. after shot _____

Gas _____ Cu. Ft.

Dry Hole _____

Abandoned _____

Date

5-23-34 19

ORVAL MANNSCHRECK

Scout