


Ellsworth

Form 51-5M-5-34-Palace

Map No. **KANSAS** Sec. 1 Twp. 17 R. 10 W

Well No. 9 Stetman Farm
El Dorado Ref. Company

NORTH

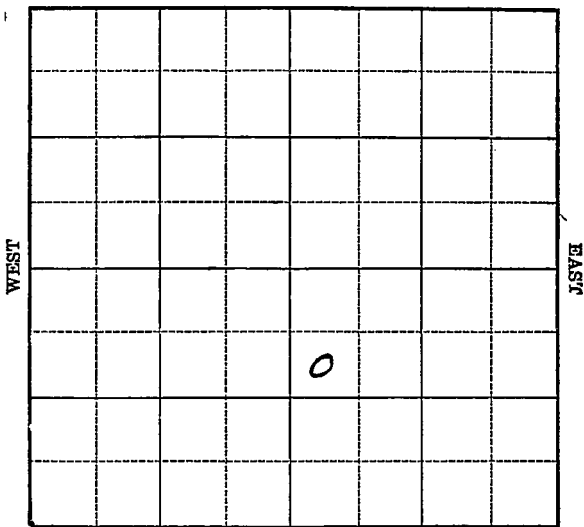

SOUTH

Location _____

Drilling Remarks _____

Rig Up _____

Drilling Remarks _____

RECORD

Cased _____ in. _____ ft.

Sand _____

Gas _____

Oil _____

Total Depth _____

PRODUCTION

1st 24 hrs. Nat. _____

1st 24 hrs. after shot _____

Gas _____ cu. ft.

Dry Hole _____

Abandoned _____

Well No. 7 Stratman Farm


El Dorado Ref Company

990 Ft. from N. Line

Ft. from S. Line

Ft. from E. Line

330 Ft. from W. Line

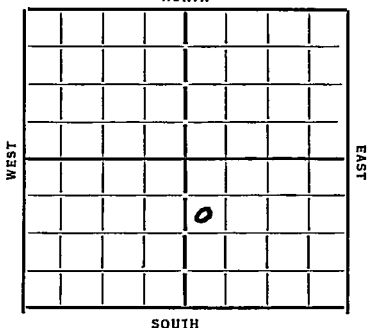

Date 1954

REPORT

6/13	Location
------	----------

6/21	Callan
------	--------

6/28	Rign up
7/5	bl. 330

17/5 104 330

7/12	15 1/2	338	15 1/2	540
------	--------	-----	--------	-----

Top salt 985 slg 1375

7/19 dby 2035 10" 1870

7/26	" 2715
------	--------

8/2	8" 2775
-----	---------

8/9 5.9. 2940-45 June 60-65

Water	3030	8 ⁰⁰	3050	71	3070
-------	------	-----------------	------	----	------

1	Lowering pipe
---	---------------

8/16 8" 3075 5.0, 3081-86
1" 3075 1.0, 3081-86

6" 3255	silicous	3251
3256	1 lb. no. 500	

TJ	3260	Arabs	100	Wols	all
111	1				

4th Mrs. P. P.

0/22	Silver Creek 2251	1/2 2251
129	1311	2.07

9 x 1 1/2 lbs 8/10 water

COMPLETED

Ellsworth

KANSAS

Map No. *55* Sec. *1* Twp. *17* R. *10W*

Well No. *9-Stratman*

El Dorado Ref Company

Contractor

FIRST REPORT

SECTION PLAT

990 Ft. from N. Line

_____ Ft. from S. Line

_____ Ft. from E. Line

330 Ft. from W. Line

		0	

Location *✓*

Rig up _____

Drilling and Remarks: _____

RECORD

Cased _____ in., _____ ft.

Sand _____

Gas _____

Oil _____

Total Depth _____

PRODUCTION

1st 24 hrs. Nat. _____

1st 24 hrs. after shot _____

Gas _____ Cu. Ft.

Dry Hole _____

Abandoned _____

Date

6-13-34

19

ORVAL MANNSCHRECK

Scout

Form 26-1M Bks. 2-29
Edenworth

KANSAS

Map No. 55 Sec. 1 Twp. 17 R. 10W

Well No. 9-Stratman
El Dorado Ref Company

Contractor

COMPLETED

SECTION PLAT

3			
	7		
		0	

990 Ft. from N. Line

_____ Ft. from S. Line

_____ Ft. from E. Line

330 Ft. from W. Line

Location _____

Rig up _____

Drilling and Remarks:

429 bbls.
20% water

RECORD

Cased _____ in., _____ ft.

Sand siliceous 3257

Gas _____

Oil _____

Total Depth 3260

PRODUCTION

1st 24 hrs. Nat. _____

1st 24 hrs. after shot _____

Gas _____ Cu. Ft.

Dry Hole _____

Abandoned _____

Date

8-22-37 19

ORVAL MANNSCHRECK
Scout