

Sec. 1 Twp. 17 R. 10-W

Well No. #3 Stratmann Farm

Robertson Oil & Hinkle Company

(Stoltenberg)

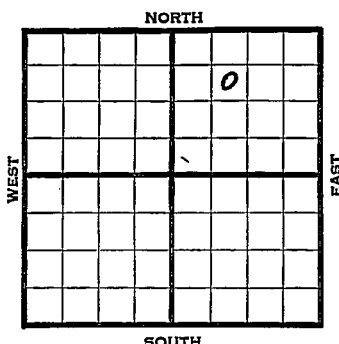
990 Ft. from N. Line

Ft. from S. Line

Fr. from E. Line

990 Ft. from W. Line

Elev. 1816

[illegible]

Map No. 55 Sec. 1 Twp. 17 R. 10WWell No. 3 StratmannRobertson Oil & Hinkle CompanyFIRST REPORT Contractor

SE NW NE

990 Ft. from N. Line Ft. from S. Line Ft. from E. Line990 Ft. from W. Line

SECTION PLAT

		o	

STOLTENBERG POOLLocation Rig up

Drilling and Remarks:

8" - 229'Waiting on
Cement to set

RECORD

Cased in., ft.Sand Gas Oil Total Depth

PRODUCTION

1st 24 hrs. Nat. 1st 24 hrs. after shot Gas Cu. Ft.Dry Hole Abandoned

Date

FEB 25 1942 19S. J. LEWIS Scout

Ellsworth

Map No. 55 Sec. 1 Twp. 17 R. 10WWell No. 3 StratmanRobertson Oil & Hinkle CompanyABANDONED

Contractor

SE NW NE

SECTION PLAT

		o	

990 Ft. from N. Line Ft. from S. Line Ft. from E. Line990 Ft. from W. Line

STOLTENBERG POOL

Location Rig up

Drilling and Remarks:

Per 83312Water-

RECORD

Cased in., ft.Sand Gas Oil Total Depth 8323

PRODUCTION

1st 24 hrs. Nat. 1st 24 hrs. after shot Gas Cu. Ft.Dry Hole Abandoned

Date

APR 22 1942 19S. J. LEWIS Scout