Form CP-4
Rev. 12-15-80

STATE OF KANSAS
STATE CORPORATION COMMISSION
200 Colorado Derby Bldg.
Wichita, Kansas 67202

WELL PLUGGING RECORD

...rmation Completely
...d Affidavit

COUNTY Ellsworth SEC. 20 TWP. 17S RGE. 10 E/W
Location as in quarters or footage from lines:
330'SL, 330' EL, SW (SE SE SW)

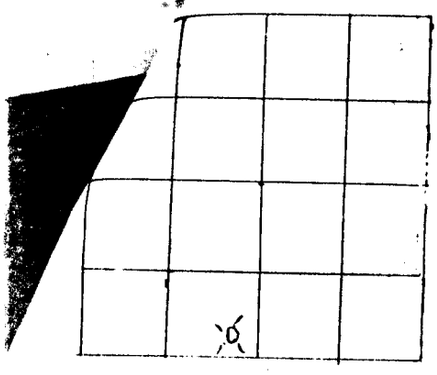

Locate Well correctly on above Section Platt.

Lease Owner Petro-Midwest Corporation
Lease Name Stumps Well No. #2
Office Address 210 E. 6th St., South Hutchinson, Kansas 67505
Character of Well (Completed as Oil, Gas or Dry Hole): Dry Hole
Date Well Completed January 22, 1982
Application for plugging filed January 22, 1982
Plugging commenced January 22, 1982
Plugging completed January 22, 1982
Reason for abandonment of well or producing formation

Was permission obtained from the Conservation Division or it's Agent's before plugging was commenced? Yes

Name of Conservation Agent who supervised plugging of this well Gilbert Toman
Producing formation Depth to top bottom T.D. 3310'
Show depth and thickness of all water, oil and gas formations.

OIL, GAS OR WATER RECORDS — Casing Record

Formation	Content	From	To	Size	Put in	Pulled Out
				8-5/8"	233'	

Describe in detail the manner in which the well was plugged, indicating where the mud fluid was placed and the method or methods used in introducing it into the hold. If cement or other plugs were used, state the character of same and depth placed, from feet to feet for each plug set.

1st Plug @ 600' w/50 sx.
2nd Plug @ 225' w/30 sx.
3rd Plug @ 40' w/10 sx.
4th Plug @ Rathole w/10 sx.

State Plugger Gilbert Toman
Plug down @ 2:30 a.m., January 22, 1982
Cement--Common, 50/50 Pozmix, 3% C.C. & 2% Gel

(If additional description is necessary, use BACK of this sheet)
Name of Plugging Contractor Sun Oil Well Cementing, Inc.

STATE OF Kansas COUNTY OF Sedgwick, ss.
K.T. Woodman, Partner Contractor (~~owner or operator~~) or (~~owner or operator~~) of the above-described well, being first duly sworn on oath, says: That I have knowledge of the facts, statements, and matters herein contained and the log of the above-described well as filed and that the same are true and correct. So help me God.

(Signature) K.T. Woodman K.T. Woodman
1008 Douglas Bldg. Wichita, KS 67202
(Address)

SUBSCRIBED AND SWORN TO before me this 26th day of January, 1982

RECEIVED

Kathryn A. Voigt
Notary Public.

My Commission expires: April 20, 1985
Kathryn A. Voigt