

LA HLIN-SIMMONS & CO. OF KANSAS, INC.  
 OILWELL ELEVATIONS AND LOCATIONS  
 2121 W. 18TH STREET (316) 943-5351  
 WICHITA, KANSAS 67203

4-16-76

Ellsworth 28 17s 10w  
 COUNTY S T R  
 Rupe Oil Co., Inc  
 OPERATOR

CE/2 SE NW NE 990 FN - 1155 - FW  
 LOCATION 1 Beck  
 NO. FARM


ELEVATION: 1818 G.

Rupe Oil Co., Inc.  
 P. O. Box 2273  
 Wichita, Kansas 67202

REC'D APR 20 1976

5' wood stake & flagging  
 Gently sloping wheat field.


SCALE: 2" = 1 Mile

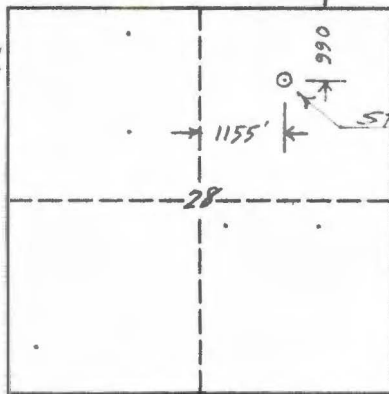

4-15-76  
 "Need 4-16-76 AM - early  
 as possible"

MINIMUM STAKING CHARGE: \$65.00  
 (INCLUDES GROUND ELEVATION)  
 EXTRA TIME & MILEAGE: 30.00 Special Trip To Site 4-16 AM  
 ELEVATION CHARGE:  
 TOTAL: \$95.00

Thanks,  
 R. E. Moser  
 L-S SURVEYOR

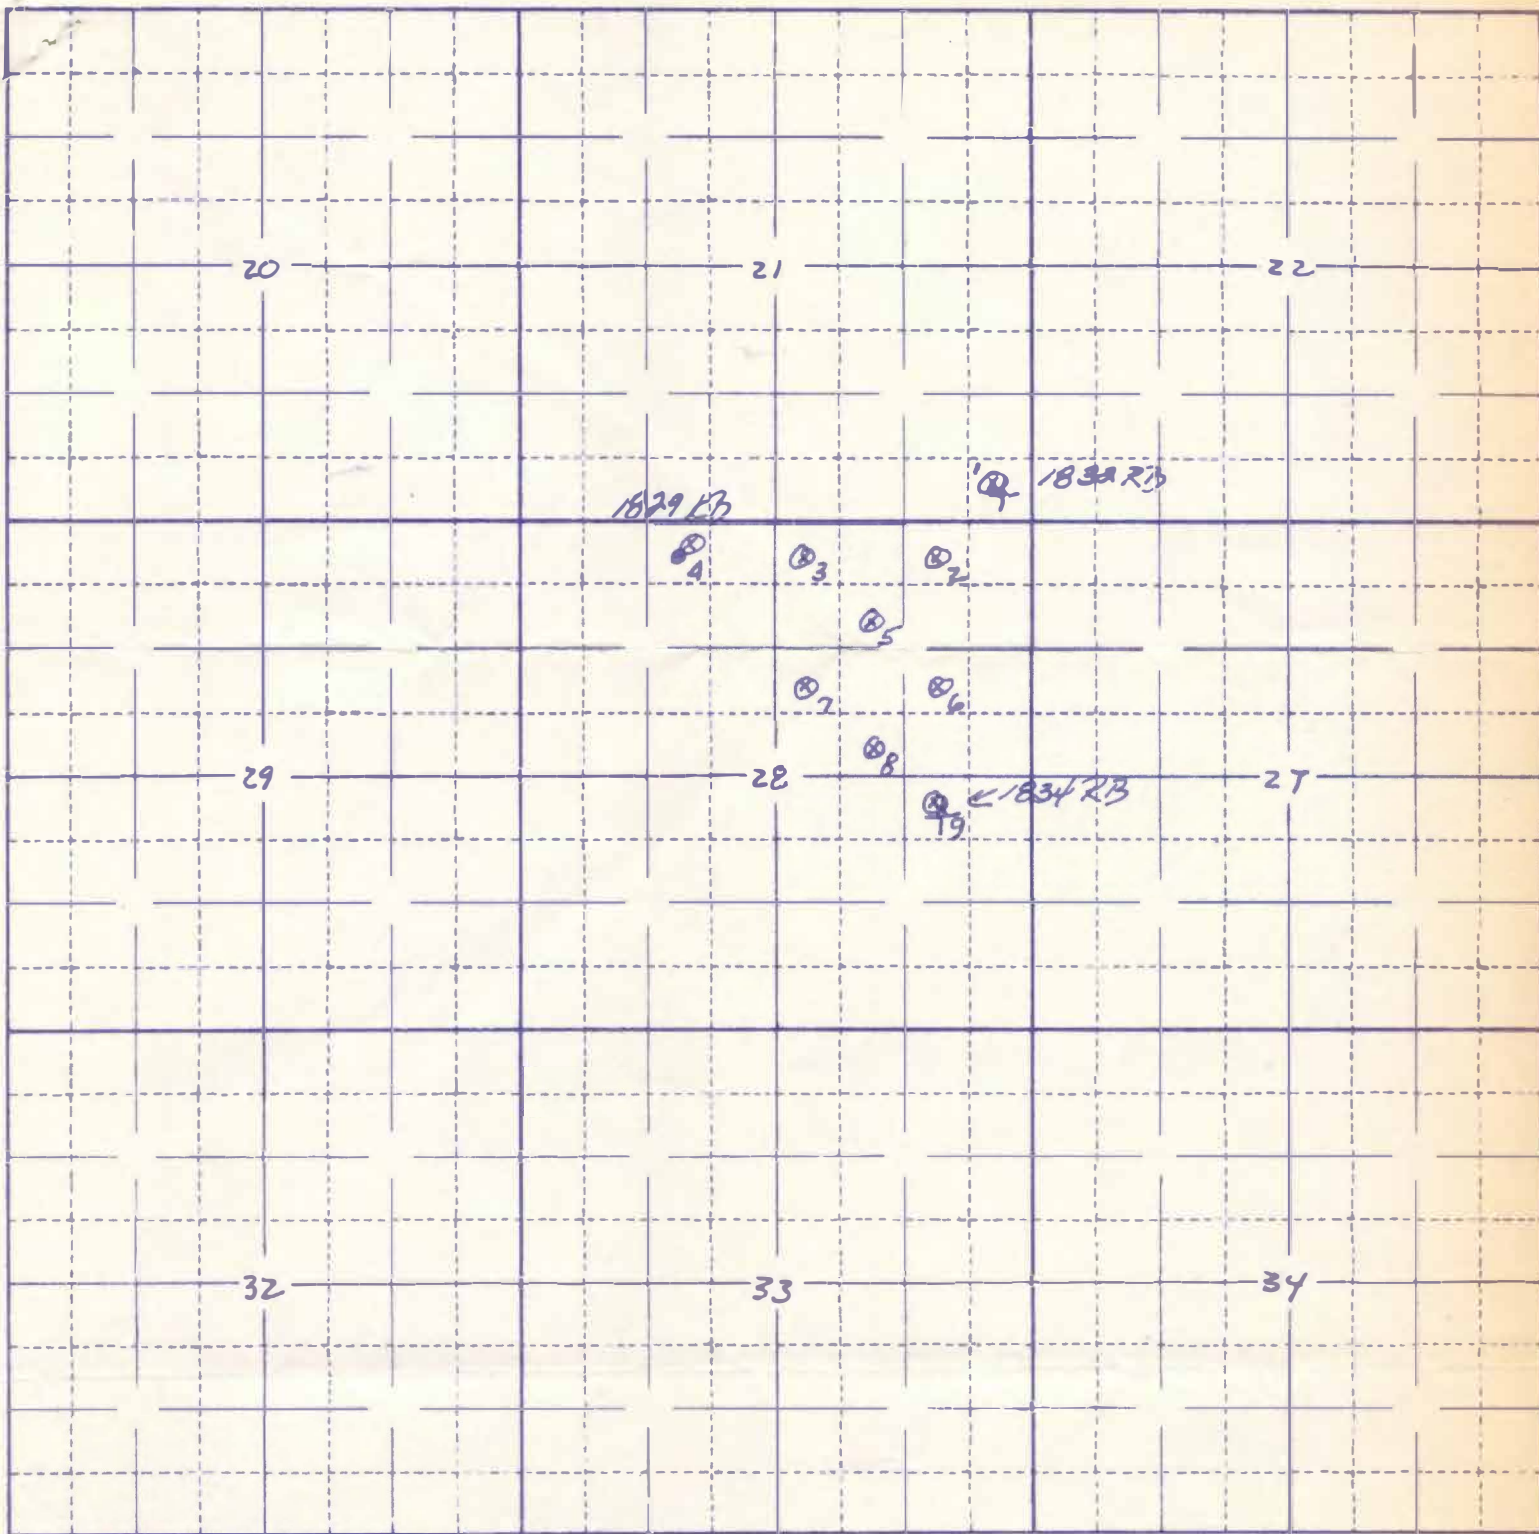

PROSPECT Beck COUNTY Ellsworth, TWSP. 17S RGE. 10W DATE 3/19/76

36	31	32	33	34	35	36	31
1	6	5	4	3	2	1	6
12	7	8	9	10	11	12	7
13	18	17	16	15	14	13	18
24	19	20	21	22	23	24	19
25	30	29	28	27	26	25	30
36	31	32	33	34	35	36	31
1	6	5	4	3	2	1	6

CONTINUOUS \_\_\_\_\_  
 SPOT CORRELATION 9(1-9)

TO BE SHOT FOR \_\_\_\_\_

COMPLETE BILLING ADDRESS \_\_\_\_\_

PRICE PER HOLE \_\_\_\_\_

USE CLIENT TOPS

USE CARD TOPS

Don: This is the Rush  
 job I talked to you  
 about. Shallow  
Anhydrite

DATE SCHEDULED \_\_\_\_\_

DATE PROMISED \_\_\_\_\_

PARTY NUMBER (3)

Central Exploration Co., Inc.

Sample Record