

LAUGHLIN-SIMMONS & CO. OF KANSAS, INC.
 OILWELL ELEVATIONS AND LOCATIONS
 2121 W. 18TH STREET
 WICHITA, KANSAS 67203 (316) 943-5351


REC'D MAR 15 1976

3-11-76

DATE
 Ellsworth 26 17s 10w NE SW SE (Relocate)
 COUNTY S T R LOCATION
 Operator Glen N. Rupe 1 Hoffman
 NO. FARM
 ELEVATION: 1795' 6"

Mr. Glen N. Rupe
 P. O. Box 2273
 Wichita, Kansas 67201

SCALE: 2" = 1 Mile

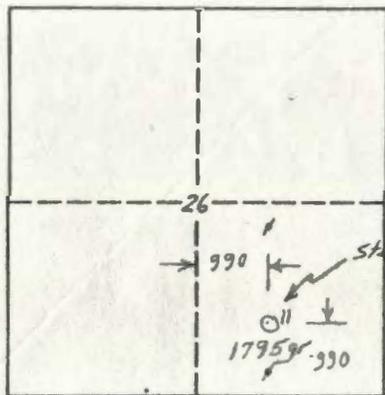


5' wood NNE side of
 apparent pit (clearing in
 wheat)
 ± 125' W of apparent water
 well (Post in gr)
 in FS obdy.

3-11-76
 "Went today"
 Red Tiger ready

MINIMUM STAKING CHARGE: \$75.00
~~(MINIMUM STAKING CHARGE)~~
 EXTRA TIME & MILEAGE: 10.00 Back track mitigate & time
 "to get today"
 ELEVATION CHARGE: _____
 TOTAL: \$85.00

Thanks
 R. E. Moser
 L-S SURVEYOR

Laughlin-Simmons & Co. of Kansas, Inc. is not liable in case of errors and/or omissions.

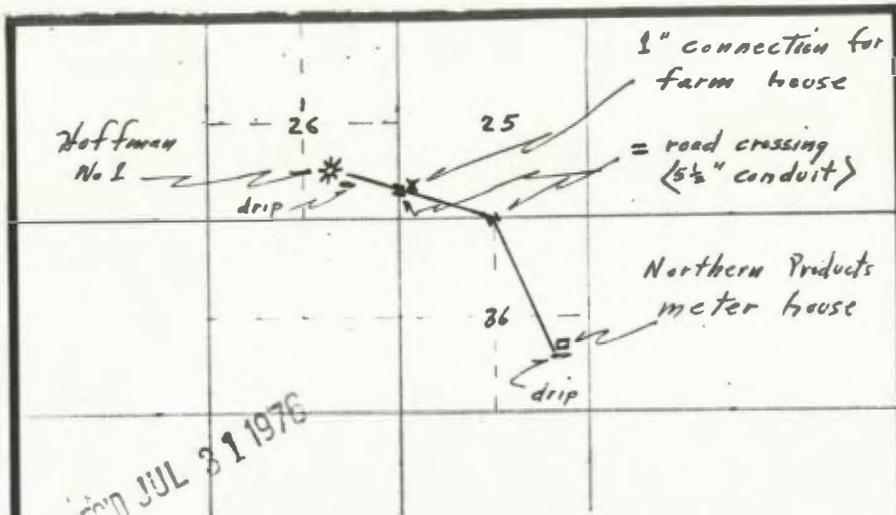

REC'D JUL 31 1976

T 17S R 10W
 Ellsworth County, Kans

Hoffman No 1 pipeline
 3 1/2" OD, 7 3/4" - welded
 tested to 1000 PSI

8712' line ditched & layed
 (welded) by
 Leonard Booth Ditching Service


John C. [Signature]
 copy

NAME OF PROSPECT Hoffman
 COMPANY G.N. Rupe

TWP 17 RGE 10W COUNTY Ellsworth STATE KANS DATE Feb. 27, 1976

Geologist W.G. Clement

NNG Pip-1112

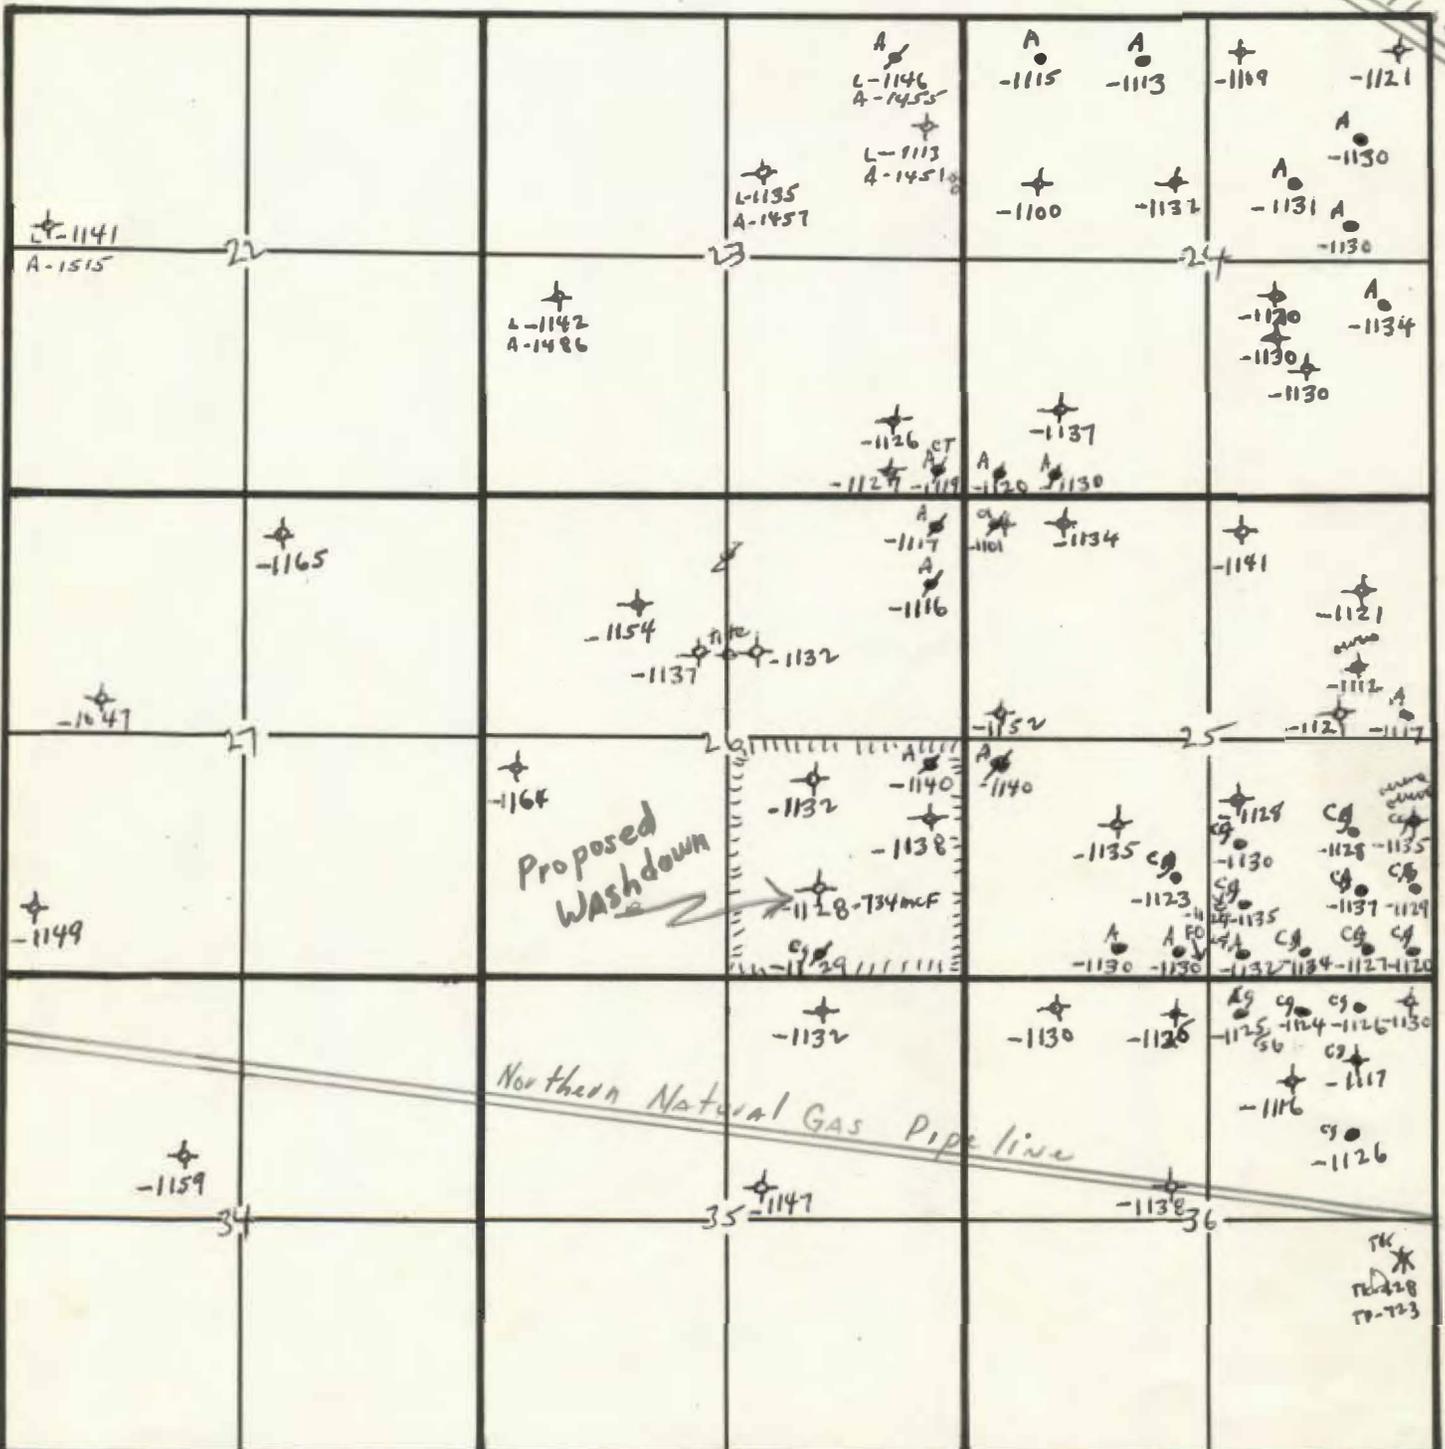

SCALE 2"=1mile
 STRUCTURE MAP = Top Landing
 C.I. =