

McPherson

KANSAS ✓

Sec. 10 Twp. 17 R. 4W

Well No. #1 Dahlsten Farm

Hanco Oil & Gas Company

B & B Drlg. Contractor

Wildcat


_____ Ft. from N. Line

330 Ft. from S. Line

_____ Ft. from E. Line

990 Ft. from W. Line

SE SW SE

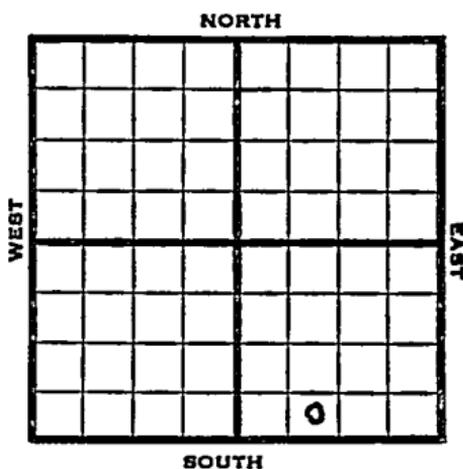

1952 Elev. 1523' REPORT

12/23 RUR

12/25 RUR

1/1 RUR

1/8 Anhy 365 10" @ 400 Doug 2353
Lans 2467 Ø2927

1/23 Spud 12-26-52

D&A

TD 3926

Anhy 365

10" @ 400

Doug 2353, Lans 2467, B KC-
2927, Miss 3212, Maq. 3681,
Simp. 3824, Arb. 3902

TD 3926

D&A

ABANDONED

