


Section 10 Township 17 Range 8 WWell No. # 2 SchumwayCompany Continental

NORTH

WEST

EAST

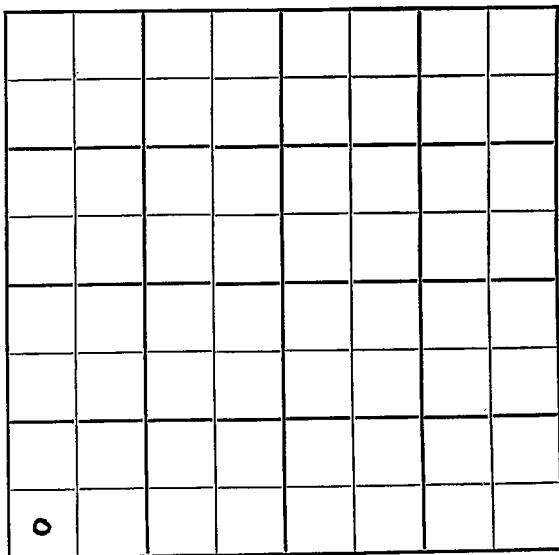

SOUTH

10

17

8W

Sec. _____ Twp. _____ R. _____

Well No. #2 Schumway Farm _____

Continental Company _____

Contractor _____


_____ Ft. from N. Line

330' Ft. from S. Line

_____ Ft. from E. Line

330' Ft. from W. Line

SW SW SW

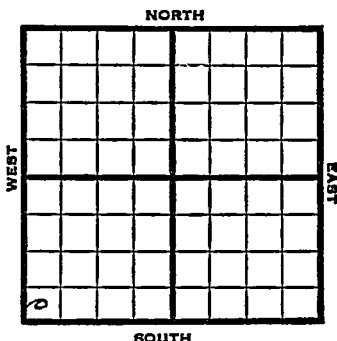

1951

Elev. 1699' REPORT

3/7

RUR

6/13

Spud 3-6-51

Oil well TD 3209' 10" @ 345

Heeb 2611' Tor. 2634' Br. lime

2731' Lans. 2752' B KC 3069'

Ch. Cong. 3109' Sd. cong. 3157-70

DST 3155-61 open 1 hr. rec 80' HOCM

DST 3161-68 open 1 hr. rec 65' HOCM

Simp. 3193' Arb. 3204-08'

5" @ 3201' CO to 3207'

S/1 BOPH DD 3209' S/2 BOPH

1000 A S/5 BOPH

Comp. 83 BOPD

COMPLETED

County **Ellsworth** State **Kansas**

Sec. 10 (Blk. Twp.) 17 (Sur. Rge.) SW Map No.

Operator Continental

Well No. **2** Farm **Schumway**

Elev.	Location	SW	SW	SW
-------	----------	----	----	----

330 Ft. From S Line SW

330 Ft. From W Line Quarter

1st. Report MAR 7 1951

Completion

Remarks


Spudding Date _____

Drlg. Data

R U R

J. E. TYRA

County Ellsworth State Kansas
 Sec. 10 (Blk. Twp.) 17 (Sur. Rge.) 8W Map No.
 Operator Continental
 Well No. 2 Farm Schumway
 Elev. 1699 Location SW SW SW

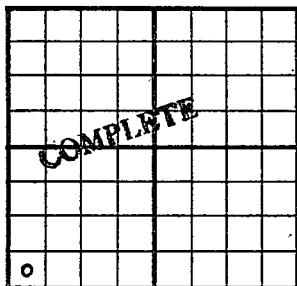

330Ft. From S Line SW
330Ft. From W Line Quarter

1st. Report

Completion JUN 13 1951

Remarks

Spudding Date 3-6-51

Drlg. Data Oil well TD 3209
10" @ 345 Heeb. 2611 Tor. 2634
Br. lime 2731 Lans. 2752 B KC 3069
Ch. Cong. 3109 Sd. cong. 3157-70
DST 3155-61 open 1 hr. Rec. 80'
hocm DST 3161-68 open 1 hr.
Rec. 65' hocm Simp. 3193
Arb. 3204-08 5" @ 3201 CO to 3207
S²/₂" 1 boph DD 3209 S/ 2 boph
1000 A S/ 5 boph Comp. 83 bopd

J. E. TYRA