


Section 10 Township 17 Range 8W

Well No. #1 Shumway "A"

Company Lohman & Johnson

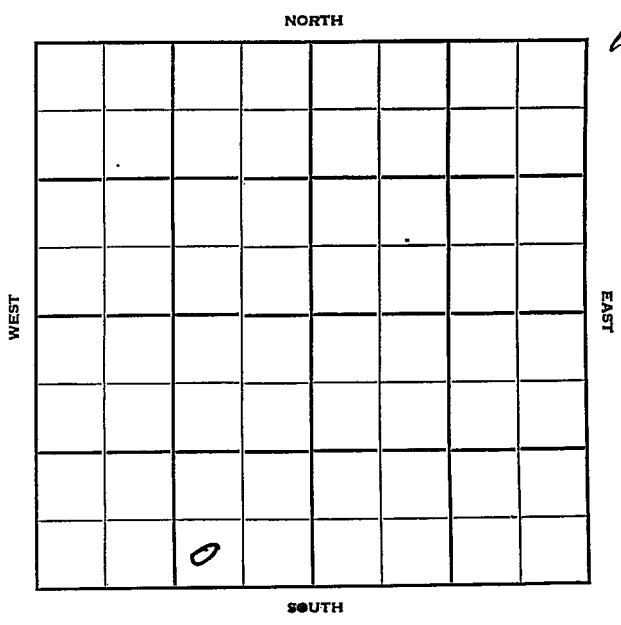

Ellsworth

Sec. 10 Twp. 17 R. 8W

Well No. #1 Shumway "A" Farm \_\_\_\_\_

Lohman & Johnson Company \_\_\_\_\_


Contractor \_\_\_\_\_

\_\_\_\_\_ Ft. from N. Line

330' Ft. from S. Line

990' Ft. from E. Line

\_\_\_\_\_ Ft. from W. Line

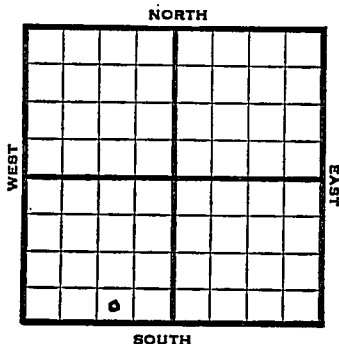

SW SE SW

1952

1738 RB  
1735 IS

REPORT

7/9

KC 2828  
Arb. 3279  
TD 3285

7/16

D & A TD 3295' Lans. 2788'  
Cong. 3162' Simp. 3264' Arb. 3279'  
TD 3285'  
DST 3279-85 open  $\frac{1}{2}$  hr. rec 1380' sul  
water. 900# TD 3295'  
D & A

**ABANDONED**



