

Section 10 Township 17 Range 8 W

Well No. # 3 Shumway

Company Continental

NORTH

12

WEST

EAST

SOUTH

0

Sec. 10 Twp. 17 R. 8 W ✓

Well No. # 3 Shumway Farm

Continental Company

Contractor

Edwards Pool


440 Ft. from N. Line

_____ Ft. from S. Line

_____ Ft. from E. Line

440 Ft. from W. Line

NW NW SW

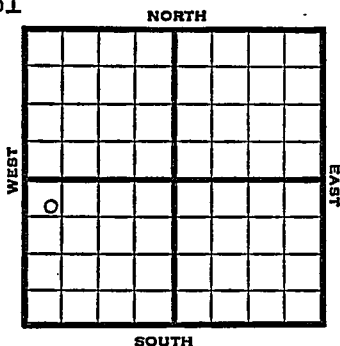

1951

Elev. 1664' REPORT

4/25

Spud 4-23-51
Set 10"

6/27

Spud 4-23-51
Oil Well TD 3231
10" @ 309
Heeb. 2572 Br lime 2690
Lans. 2711 Viola 3111
Simp. 3156
DST 3160-65 opn 45 min. Rec. 120'
free oil 270' mud & oil
DST 3165-70 opn 1/2 hr Rec. 180' oil
240' mud & oil
DST 3170-75 opn 1/2 hr Rec. 320' oil
60' mud & oil Arb. 3211
DST 3208-15 opn 15 min. Rec. 540'
oil 300' sw
DST 3212-15 opn 15 min Rec. 300'
ocsw 120' sw TD 3231 5" @ 3230
12/3208-12 S/43 bo 60 bw 8 hr
PB 3190 DC 3218 36/3208-11
S/38 bo 19 bw 1 hr Comp. 252 bopd
12% wtr.

COMPLETED

