


Section 10 Township 17 Range 8 W

Well No. # 4 Shumway

Company Continental Oil

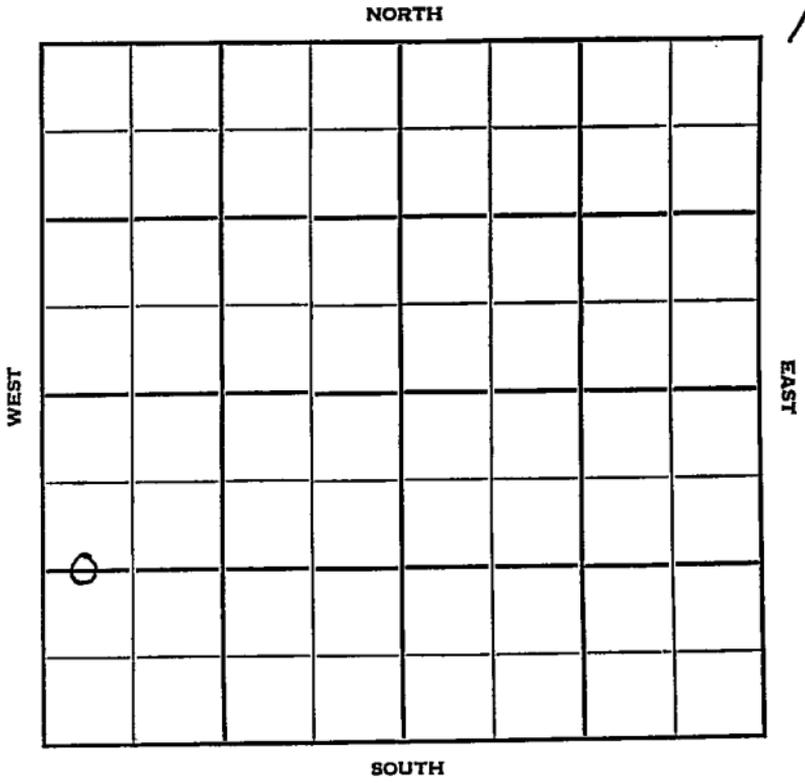

Sec. 10 Twp. 17 R. 8 W ✓

Well No. # 4 Shumway Farm

Continental Oil Company

Contractor

Edwards Pool


Ft. from N. Line

1320 Ft. from S. Line

Ft. from E. Line

330 Ft. from W. Line

C $W\frac{1}{2}$ $W\frac{1}{2}$ SW

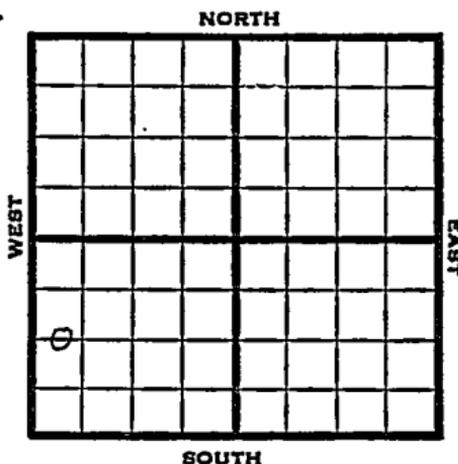

1951 Elev. 1693' REPORT

5/2 Location
8/15 Spud 6-9-51
Oil well TD 3254' 10" @ 304
Heeb 2603' Br. lime 2723'
Lans. 2745' Viola 3151' Simp 3189'
DST 3194-3212 open 1 hr. rec 440' O &
GCM. Arb. 3243'
DST 3244-46 open 10 min. rec 160' sul
water & 300' mud TD 3251'
5" @ 3249' 7/3240-42 500 A
25/3242-47 DD 3254 water
PB 3230' 48/3188-3202'
FU 260' oil 70 min. 5/8 BOPH
Comp. 217 BOPD

COMPLETED

County **Ellsworth** State **Kansas**

Sec. **10** (Bik. Twp.) **17** (Sur. Rge.) **8W** Map No.

Operator **Continental Oil**

Well No. **4** Farm **Shumway**

Elev. **1693** Location **C W $\frac{1}{2}$ W $\frac{1}{2}$ SW**

1320 Ft. From **S** Line **SW**

330 Ft. From **W** Line **Quarter**

1st. Report **MAY 2 1961**

Completion

Remarks

Spudding Date

Drlg. Data **Edwards Pool**

Location

County Ellsworth State Kansas

Sec. 10 (Blk.) 17 (Sur.) 8W Map No.

Operator Continental Oil

Well No. 4 Farm Shumway

Elev. 1693 Location C W $\frac{1}{2}$ W $\frac{1}{2}$ SW

COMPLETE									

1320 Ft. From S Line SW

330 Ft. From W Line Quarter

Ist. Report

Completion AUG 15 1951

Remarks Edwards Pool

Spudding Date 6-9-51

Drlg. Data Oil well TD 3254

10" @ 304 Heeb. 2603 Br. lime 2723

Lans. 2745 Viola 3151 Simp. 3189

DST 3194-3212 open 1 hr. Rec. 440'

o & gcm Arb. 3243 DST 3244-46 open

10 min. Rec. 160' sul. water & 300' mud

TD 3251 5" @ 3249 7/ 3240-42 500 A

25/ 3242-47 DD 3254 water PB 3230

48/ 3188-3202 FU -260' oil 70 min.

S/ 8 bopd Comp. 217 bopd