

Section 10 Township 17 Range 8 WWell No. # 5 ShumwayCompany Continental Oil

NORTH

13

SOUTH

WEST

EAST

0.

2

Ellsworth

KANSAS

Sec. 10 Twp. 17 R. 8 W V

Well No. # 5 Shumway Farm

Continental Oil Company

Contractor

Edwards Pool


Ft. from N. Line

330 Ft. from S. Line

Ft. from E. Line

990 Ft. from W. Line

SE SW SW

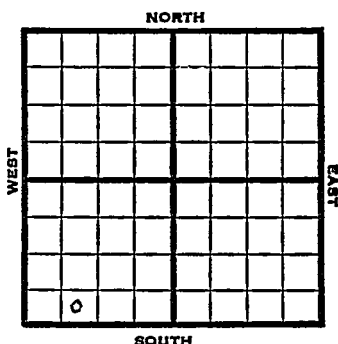

1951

Elev. 1701' REPORT

5/23

Location

6/20

Spud 5-26-51
Oil Well TD 3243
10" @ 300'
Simp. 3183
DST 3184-3204 opn $\frac{1}{2}$ hr
Rec 10' mud
Arb. 3231
DST 3232-38 opn 10 min.
Rec. 405' oil 120' wtr
TD 3243 5" @ 3242
Heeb. 2609 Br Lime 2723
Lans. 2745 Cong. 3096
3/3238-39 12/3233-37
FU 240' oil 20 min.
SP 3240
Comp. 183 bopd

COMPLETED



(Blk.)
(Twp.)

Continental Oil

5 Farm Shumway

SE SW STE

FIRST REPORT

330 Ft. From S Line SW

990 Ft. From W Line Quarter

MAY 23 1951

Completion

Remarks


Spudding Date

Edwards Pool

Location

J. E. TYRA

County Ellsworth State Kansas
 Sec. 10 (Blk. 17 (Sur. 8W Map No.
 (Twp.) (Rge.)
 Operator Continental Oil
 Well No. 5 Farm Shumway
 Elev. 1701 Location SE SW SW

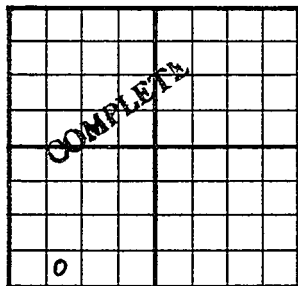

330 Ft. From S Line SW
990 Ft. From W Line Quarter
 1st. Report
 Completion JUN 20 1951
 Remarks Edwards Pool

Spudding Date 5-26-51

Drlg. Data Oil well TD 3243

10" @ 300 Simp. 3183 DST 3184-3204

open $\frac{1}{2}$ hr. Rec. 10' mud Arb. 3231

BST 3232-38 open 10 min. Rec. 405' oil

120' water TD 3243 5" @ 3242

Heeb. 2609 Br. lime 2723 Lans. 2745

Cong. 3096 3/ 3238-39 12/ 3233-37

FU 240' oil 20 min. SP 3240

Comp. 183 bopd

J. E. TYRA