


WELL LOG BUREAU — KANSAS GEOLOGICAL SOCIETY
412 Union National Bk. Bldg., Wichita, Kansas

Company - ALEDO OIL AND GAS CO. & MURFIN DRG.
Farm - Boor No. 1

SEC. 7 T. 17 R. 11W
NW NW NW

Total Depth. 3367
Comm. 4-22-49 Comp. 5-2-49
Shot or Treated.
Contractor. Murfin Drlg. Co.
Issued. 5-21-49

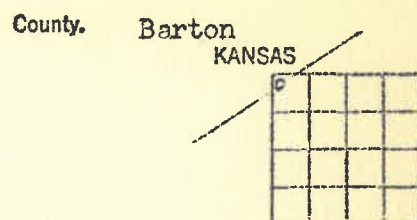

8 1/4" 225' CASING:
cem w/100 sx.

Elevation. _____

Production. Dry

Figures Indicate Bottom of Formations.

shale	40
shale, shells	180
sand	188
shale, shells	250
sand, shale	330
shale, shells	470
red bed	725
anhydrite	758
shale, shells	1200
salt, shale	1350
shale, shells	1490
lime, shale	1810
lime brkn	1855
lime	1900
shale	1915
lime	1995
lime, shale	2010
shale	2075
shale, lime	2295
lime	2330
shale, lime brkn	2475
lime brkn	2530
shale	2555
shale, lime	2620
lime brkn	2710
lime	2845
chert	2847
lime	2950
shale, lime	3040
lime	3313
shale, lime	3325
conglomerate	3335
conglomerate Cherty	3354
Arbuckle lime	3367
Total depth	

Tops: Corr. to Derrick floor

Topeka	2669
Heebner	2945
Brown Lime	3040
Lansing	3054
Conglomerate	3315
Conglomerate Cherty	3333
Arbuckle	3352