


Section 11 Township 17 Range 9W

Well No. #2 Schmidt

Company Petroleum Inc.

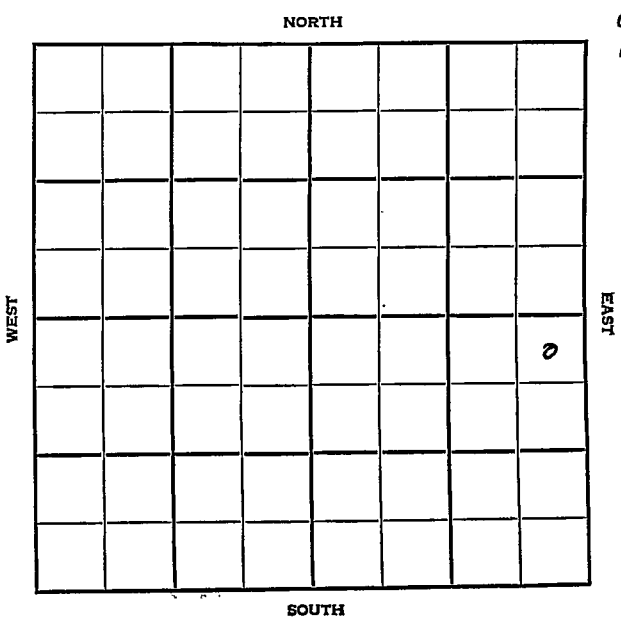

Ellsworth

KANSAS

SEC.	TWP.	R.
11	17	9 W

WELL NO. # 2 Schmidt FARM

COMPANY Petroleum Inc. CONTRACTOR


Petroleum Inc. N. Lorraine Pool

330 Ft. from N. Line

Ft. from S. Line

330 Ft. from E. Line

Ft. from W. Line

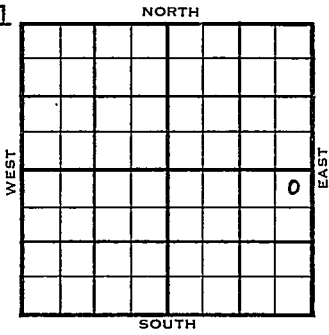

NE NE SE

	ELEVATION	REPORT
1954	1811'	

9/8 Location

9/22 Spud 9-8-54 D & A TD 3270
 8" @ 228 Lans 2068 Anhy 450
 Heeb 2731 Br. line 2850
 DST 3051-76 open 1 hr rec 30' SO &
 GCM O# Cong. 3192 Simp 3200
 Arb. 3245 TD 3270
 D & A

ABANDONED

