

Ellsworth

Map No. KANS Sec. 11 Twp. 17 R. 9W

Well No. 1- Schmidt Farm
Empire Oil Company


 Ft. from N. Line

330 Ft. from S. Line

330 Ft. from E. Line

 Ft. from W. Line

NORTH

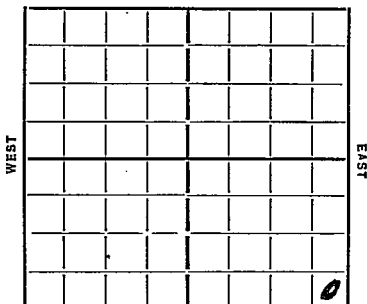

SOUTH

Elev. 1802

Date 7/10 REPORT

7/10 Rog
7/18 15" 404 WOC
8/8 Lil 3216 200 Oil 3216 1/2
 2600 3217 tabg
8/5 210 Oil 1145 W10 her
 pump off.
8/22 pump 401 Oil 405 W 21 her
8/28 Lil 3216
 T7 3217
 500 Oil
 540 Wto.

COMPLETED

KANSAS

Map No. 45 Sec. 11 Twp. 17 R. 9WWell No. 1-SchmidtEmpire Oil Company

Contractor

COMPLETED

SECTION PLAT

Ft. from N. Line

330 Ft. from S. Line330 Ft. from E. Line

Ft. from W. Line

Location

Rig up

Drilling and Remarks:

500 oil
540 water

RECORD

Cased _____ in., _____ ft.

~~Sand~~ sil 3216

Gas _____

Oil _____

Total Depth 3217

PRODUCTION

1st 24 hrs. Nat. _____

1st 24 hrs. after shot _____

Gas _____ Cu. Ft.

Dry Hole _____

Abandoned _____

Date

8-28-35 192

J. AL. MANNSCHRECK

Scout

Edgeworth
 Map No. *245* Sec. *11* Twp. *17* R. *9W*
 Well No. *1 - Schmidt*
Empire oil Company
 Contractor

FIRST REPORTS

SECTION PLAT

			0

Ft. from N. Line

330 Ft. from S. Line*330* Ft. from E. Line

Ft. from W. Line

Location

Rig up

Drilling and Remarks:

Log

RECORD

Cased.....in.,ft.

Sand.....

Gas.....

Oil.....

Total Depth.....

PRODUCTION

1st 24 hrs. Nat.....

1st 24 hrs. after shot.....

Gas.....Cu. Ft.

Dry Hole.....

Abandoned.....

Date

OPVAL MANNSCHECK

7-10-35 192.....Scout