


KANSAS Ellsworth

FORM 51 5M PETROL

Section 11 Township 17 Range 10W

Well No. 2 Frevert

Company Lauck & Moncrief

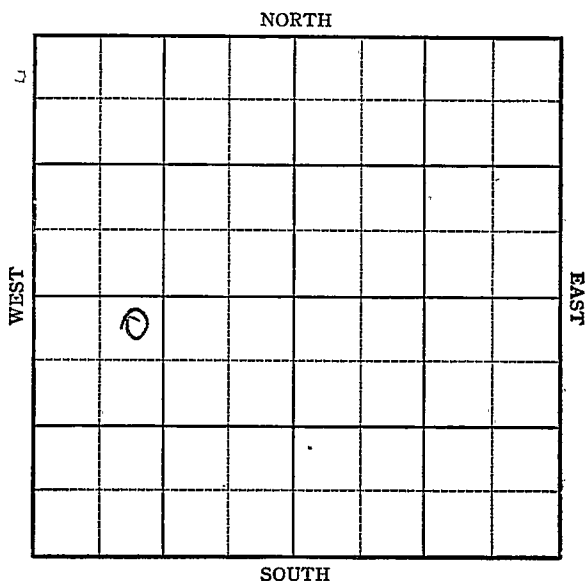

Sec. 11 Twp. 17 R. 10W

Well No. 2 Frevert Farm

Lauck & Moncreife Company

Stoltenberg


330 Ft. from N. Line

Ft. from S. Line

Ft. from E. Line

990 Ft. from W. Line

NE NW SW Elev. 1803

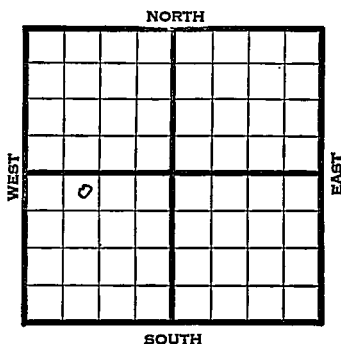

1945

REPORT

5/16 Location
5/24 Derrick
5/31 10" @ 189' WOC
6/8 Drlg. 2720
6/14 Lams 2935
Cong 3238
Arb 3239-44 TD
5" @ 3239' RUST
6/21 Arb 3243
5" @ 3243
TD 3294 swb 15 oil PH 9 hrs.
6/28 " " " "
7/3 " " " "
7/11 " " " "
7/18 Arb. 3243
5" @ 3243
TD 3294'
Pump 181 Pot.
Grav. 42.4

COMPLETED

Kansas Pool Name StoltenbergMap No. 55 Sec. 11 Twp. 17 R. 10WWell No. 2 RevertLauck & Moncrief Company

FIRST REPORT

Contractor

NE NW SW

SECTION PLAT

330 Ft. from N. Line Ft. from S. Line Ft. from E. Line990 Ft. from W. Line

0			

EllsworthLocation XRig up

Drilling and Remarks:

RECORD

Cased in., ft.Sand Gas Oil Total Depth

PRODUCTION

1st 24 hrs. Nat. 1st 24 hrs. after shot Gas Cu. Ft.Dry Hole Abandoned

Date

MAY 16 1945 19S. J. LEWIS Scout

Kansas Pool Name StoltenbergMap No. KANSAS Sec. 11 Twp. 17 R. 10WWell No. 2 FrevertLauck and Moncrief Company**COMPLETED**

Contractor

NE NW SW

E. 1823

SECTION PLAT

330 Ft. from N. Line Ft. from S. Line Ft. from E. Line990 Ft. from W. Line

6			
	1		

Ellsworth County

Location Rig up

Drilling and Remarks:

CR 432435" @ 3243Pray 181 RY42 1/2 Gr**RECORD**Cased in. ft.Sand Gas Oil Total Depth 3294**PRODUCTION**1st 24 hrs. Nat. 1st 24 hrs. after shot Gas Cu. Ft.Dry Hole Abandoned

Date

JUL 1 8 1945 19S. J. LEWIS

Scout