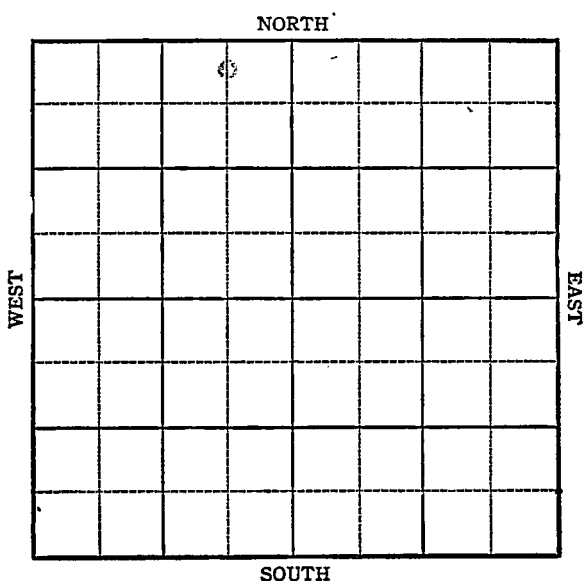


KANSAS

Ellsworth

FORM 51 5M BRIX

Section 11 Township 17 Range 10WWell No. #1, PhelanCompany Atlantic

KANSAS

Ellsworth

Sec. 11 Twp. 17 R. 10W

Well No. #1 Phelan Farm

Atlantic

Company


Bloomer

330 Ft. from N. Line

 Ft. from S. Line

660 Ft. from E. Line

 Ft. from W. Line

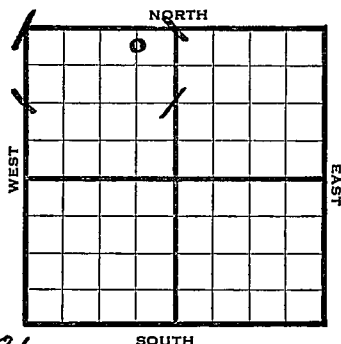

elev. 1781

1944

REPORT

5/31

Location

6/7

8" @ 333 WOC

6/15

Lans 2919

Drig. @ 3150'

6/21

Cong. 3225

Arb. 3271-82 TD

5" @ 3272

RUST

6/28

"

7/12

Arb 3271

5" @ 3272

5 qts

1300 Acid

Water

TD 3307

ABANDONED

Pool Name Bloomer


KANSAS
 Map No. 5 Sec. 11 Twp. 17 R. 10W

Well No. 1 PhelanAtlantic

Company

FIRST REPORT

Contractor

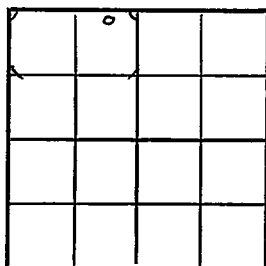C N L NE NW**SECTION PLAT**330 Ft. from N. Line Ft. from S. Line660 Ft. from E. Line Ft. from W. LineEllsworth CountyLocation XRig up

Drilling and Remarks:

RECORDCased in., ft.Sand Gas Oil Total Depth **PRODUCTION**1st 24 hrs. Nat. 1st 24 hrs. after shot Gas Cu. Ft.Dry Hole Abandoned

Date

MAY 3 1 1944 19S. J. LEWIS

Scout

Pool Name BloomerMap No. Δ KANSAS Sec. 11 Twp. 17 R. 10WWell No. 1 PhelanAtlantic CompanyABANDONED Contractor

C N L NE NW

SECTION PLAT

330 Ft. from N. Line Ft. from S. Line660 Ft. from E. Line Ft. from W. Line

	a		

Ellsworth CountyLocation Rig up

Drilling and Remarks:

Per X3271
5" @ 3272
59 to
1800 acid
Water

RECORD

Cased in., ft.Sand Gas Oil Total Depth 3367

PRODUCTION

1st 24 hrs. Nat. 1st 24 hrs. after shot Gas Cu. Ft.Dry Hole Abandoned

Date

JUL 12 1944 19S. J. LEWIS Scout