

Section 11 Township 17 Range 10-W

Well No. #3 Frevert

Company D. R. Lauck  
Stoltenberg.

NORTH


WEST

EAST

SOUTH

KANSAS

Ellsworth ✓

Sec. 11 Twp. 17 R. 10W

Well No. #3 Frevort Farm \_\_\_\_\_

D. R. Lauck Company \_\_\_\_\_

**Stoltenberg**


990' Ft. from N. Line

\_\_\_\_\_ Ft. from S. Line

\_\_\_\_\_ Ft. from E. Line

990' Ft. from W. Line

SE NW SW

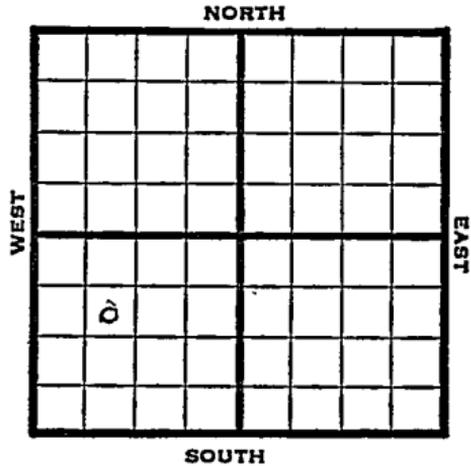

1948 Elev. 1798' REPORT

6/23 10" @ 109'  
Drlg. 1050'

6/29 Arbuckle 3246'  
TD 3250'  
5" @ 3246'  
RUST

7/8 Arbuckle 3246'  
5" @ 3246'  
Pump 25 oil Pot.  
Gr. 42.6°  
TD 3280'

**COMPLETED**

Map No. \_\_\_\_\_ Sec. 11 Twp. 17 R. 10W

Well No. 3 Frevert

D. R. Lauck Company

FIRST REPORT Contractor

SE NW SW

SECTION PLAT

990 Ft. from N. Line

\_\_\_\_\_ Ft. from S. Line

\_\_\_\_\_ Ft. from E. Line

990 Ft. from W. Line


Ellsworth County

Location \_\_\_\_\_

Rig up \_\_\_\_\_

Drilling and Remarks:

10" @ 109

drlg. 1050

RECORD

Cased \_\_\_\_\_ in., \_\_\_\_\_ ft.

Sand \_\_\_\_\_

Gas \_\_\_\_\_

Oil \_\_\_\_\_

Total Depth \_\_\_\_\_

PRODUCTION

1st 24 hrs. Nat. \_\_\_\_\_

1st 24 hrs. after shot \_\_\_\_\_

Gas \_\_\_\_\_ Cu. Ft.

Dry Hole \_\_\_\_\_

Abandoned \_\_\_\_\_

Date

JUN 23 1948 19 S. J. LEWIS Scout

Map No. 55 Sec. 11 Twp. 17 R. 10W

Well No. 3 Frevert

D. R. Lauck Company

**COMPLETE**

Contractor

SE NW SW

*E. 11998*  
SECTION PLAT

990 Ft. from N. Line

\_\_\_\_\_ Ft. from S. Line

\_\_\_\_\_ Ft. from E. Line

990 Ft. from W. Line


Ellsworth County

Location \_\_\_\_\_

Rig up \_\_\_\_\_

Drilling and Remarks:

*Cor 8246*

*5" @ 8246*

*Pump 25 oil*

*42 1/2 gal.*

**RECORD**

Cased \_\_\_\_\_ in., \_\_\_\_\_ ft.

Sand \_\_\_\_\_

Gas \_\_\_\_\_

Oil  \_\_\_\_\_

Total Depth 8288

**PRODUCTION**

1st 24 hrs. Nat. \_\_\_\_\_

1st 24 hrs. after shot \_\_\_\_\_

Gas \_\_\_\_\_ Cu. Ft.

Dry Hole? \_\_\_\_\_

Abandoned \_\_\_\_\_

Date

JUL 8 1948

19

S. J. LEWIS

Scout