

Section 11 Township 17 Range 10W

Well No. 4 Fervert

Company D.R. Lauck

Stoltenberg

NORTH

WEST

EAST

SOUTH

KANSAS

Ellsworth

Sec. 11 Twp. 17 R. 10W ✓


Well No. #4 Fervert Farm
D. R. Lauck Company
Stoltenberg Pool

990' Ft. from N. Line

_____ Ft. from S. Line

990' Ft. from E. Line

_____ Ft. from W. Line

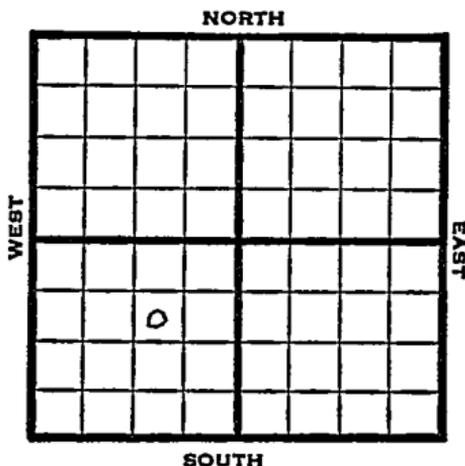

SW NE SW

1949

Elev 1782'

REPORT

6/1 Drlg. 1427'

6/7 Drlg. 3000'

6/15 Lansing 2918'

Arb. 3230-35'

TD 3235'

5"@ 3232'

6/21 TD 3266

Wtr

PB 3242'

6/29 TD 3266'

Arb. 3230'

5"@ 3232'

Pump 100 oil Pot

44° Gr.

Comp

COMPLETED

Kansas

Map No. _____ Sec. 11 Twp. 17 R. 10WWell No. 4 Fervert

_____ D. R. Lauck _____ Company

_____ Contractor

SW NE SW

FIRST REPORT
SECTION FLAT990 Ft. from N. Line

_____ Ft. from S. Line

990 Ft. from E. Line

_____ Ft. from W. Line

	o		

_____ Ellsworth County

Location _____

Rig up _____

Drilling and Remarks:

drlg. 1427

RECORD

Cased _____ in., _____ ft.

Sand _____

Gas _____

Oil _____

Total Depth _____

PRODUCTION

1st 24 hrs. Nat. _____

1st 24 hrs. after shot _____

Gas _____ Cu. Ft.

Dry Hole _____

Abandoned _____

Date

JUN 1 1949

19

S. J. LEWIS Scout

