


Section 11 Township 17 Range 10W

Well No. 5 Frevert

Company D.R. Lauck

### Stoltenberg NORTH

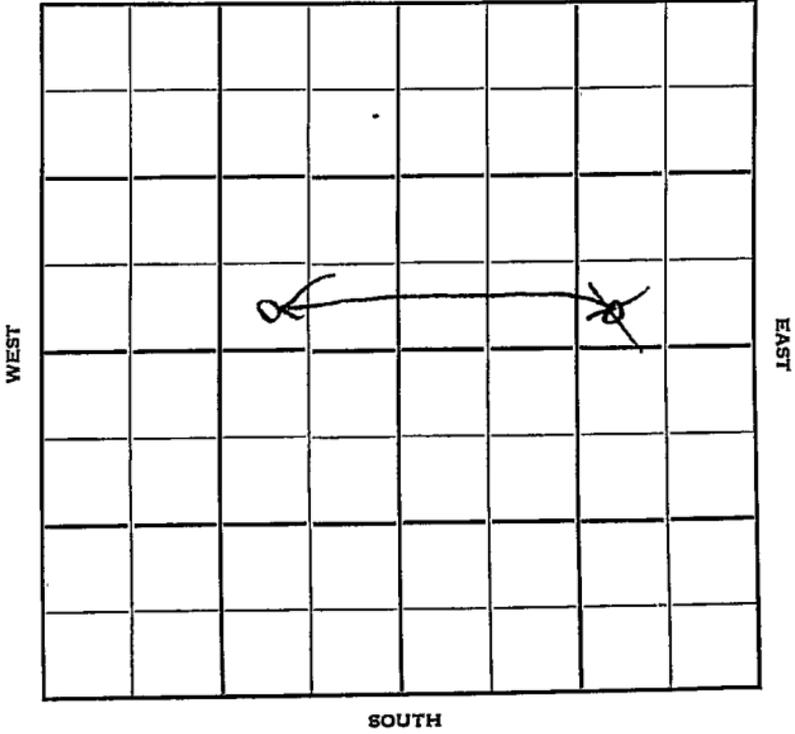

**HOT FILE**

Elisworth  
17

KANSAS

Sec. 11 Twp. \_\_\_\_\_ R. 10W ✓

Well No. #5 Frevert Farm \_\_\_\_\_

D. R. Lauck Company \_\_\_\_\_

Stoltneberg Pool


\_\_\_\_\_ Ft. from N. Line

330' Ft. from S. Line

990' Ft. from E. Line

\_\_\_\_\_ Ft. from W. Line

SW SE NE  
NW

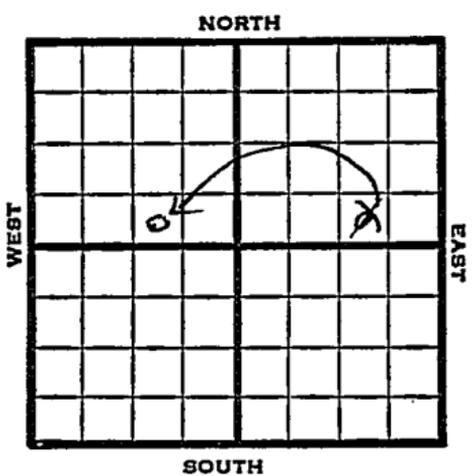

**CLOSE TO OUR ACREAGE REPORT**

1949

Elev. 1797'

6/15

10" @ 191'

6/21

Drlg 3010'

6/28

Lansing 2928'

Arb. 3246'

TD 3320'

5" @ 3320'

7/6

72 shots 3268-75

Swb 6 bbls oil PH - 3 hrs.

Complete

7/20

Arb. 3246'

5" @ 3320'

Perf. Arb.

Pump 100 pot.

42.6 Grav.

TD 3320'

**COMPLETED**




25 \_\_\_\_\_

T \_\_\_\_\_

W

2

 

\_\_\_\_\_

\_\_\_\_\_

\_\_\_\_\_

\_\_\_\_\_

25

Scout Cards	.....
Land Small Map	.....
Land Wall Map	.....
Tracings	.....
France Map	.....
Pierce Map	.....
Misc.	.....

Map No. \_\_\_\_\_ Sec. 11 Twp. 17 R. 10W

Well No. 5 Frevert

D. R. Lauck Company

CORRECTION Contractor

SW SE NW

SECTION PLAT

\_\_\_\_\_ Ft. from N. Line

330 Ft. from S. Line

990 Ft. from E. Line

\_\_\_\_\_ Ft. from W. Line

	<i>D</i>		

Ellsworth County

Location \_\_\_\_\_

Rig up \_\_\_\_\_

Drilling and Remarks:

Reported

SW SE NE

RECORD

Cased \_\_\_\_\_ in., \_\_\_\_\_ ft.

Sand \_\_\_\_\_

Gas \_\_\_\_\_

Oil \_\_\_\_\_

Total Depth \_\_\_\_\_

PRODUCTION

1st 24 hrs. Nat. \_\_\_\_\_

1st 24 hrs. after shot \_\_\_\_\_

Gas \_\_\_\_\_ Cu. Ft.

Dry Hole \_\_\_\_\_

Abandoned \_\_\_\_\_

Date

JUN 22 1949

S. J. LEWIS Scout

Scout Co. r  
Land Sm  
Land War  
Tracings  
France Map  
Pierce Map  
Misc.

A large, dark, handwritten scribble is present over the right side of the list. Below the scribble, there are checkmarks next to the items "France Map" and "Pierce Map".

Kansas

Stoltenberg Pool

Map No. K55 Sec. 11 Twp. 17 R. 10WWell No. 5 Frevert

D. R. Lauck

Company

COMPLETE

Contractor

SW SE NW


E1.179?  
SECTION PLAT

\_\_\_\_\_ Ft. from N. Line

330 Ft. from S. Line990 Ft. from E. Line

\_\_\_\_\_ Ft. from W. Line

Ellsworth County

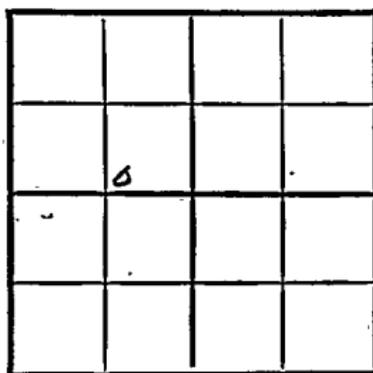

Location \_\_\_\_\_

Rig up \_\_\_\_\_

Drilling and Remarks:

Art 32465" @ 3220Perf artPump 100 Post42 1/2

## RECORD

Cased \_\_\_\_\_ in., \_\_\_\_\_ ft.

Sand \_\_\_\_\_

Gas \_\_\_\_\_

Oil \_\_\_\_\_

Total Depth 3220

## PRODUCTION

1st 24 hrs. Nat. \_\_\_\_\_

1st 24 hrs. after shot \_\_\_\_\_

Gas \_\_\_\_\_ Cu. Ft.

Dry Hole \_\_\_\_\_

Abandoned \_\_\_\_\_

Date

JUL 20 1949

19

S. J. LEWIS

Scout

Scout Cards .....  
Land Small Map .....  
Land Wall Map .....  
Tracings .....  
France Map .....  
Pierce Map .....  
Misc. ....