

Section 11 Township 17 Range 10WWell No. #8 FrevertCompany D. R. Lauck

NORTH

		1					
0							

WEST

EAST

SOUTH

KANSAS

Ellsworth

Sec. 11 Twp. 17 R. 10-W

Well No. #8 Frevert ☒ Farm

D R Lauck Company

Stoltengerg Contractor


990 Ft. from N. Line

 Ft. from S. Line

 Ft. from E. Line

330 Ft. from W. Line

SW NW SW

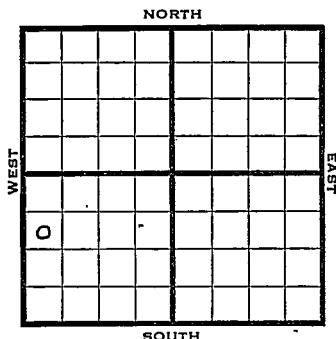

1950

Elev 1804

REPORT

8/30 Location

9/20 Spud 8-31-50

10" @ 203

Heeb 2813

Cong 3248

5½" @ 3256

TD 3283 500 A Comp 25 bopd

Completed

Lans 2941

Arb 3256-59


COMPLETED

Scout Cards	7 W
Land Small Map	
Land Wall Map	3
Tracings	
France Map	
Pierce Map	
Misc.	

S.D.P.

1950

Drig. Data

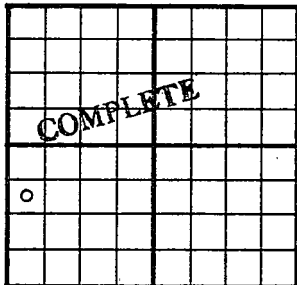County Ellsworth State KansasSec. 11 (Blk.
Twp.) 17 (Sur.
Rge.) 10W Map No.Operator D. R. LauckWell No. 8 Farm FrevertElev. 1804 Location SW NW SW990 Ft. From N Line SW330 Ft. From W Line Quarter1st. Report ~~SEP 20 1950~~Completion SEP 20 1950

Remarks

Stoltenberg PoolSpudding Date 8-31-50Drlg. Data Oil well TD 328310" @ 203 Heeb. 2813 Lans. 2941Cong. 3248 Arb. 3256-59 5 $\frac{1}{2}$ " @ 3256TD 3283 500 A Comp. 25 bopd

J. E. TYRA

70

Scout Cards	
Land Small Map	
Land Wall Map	
Tracings	
France Map	
Pierce Map	
Misc.	

SEP 25 1950

Prty. Date