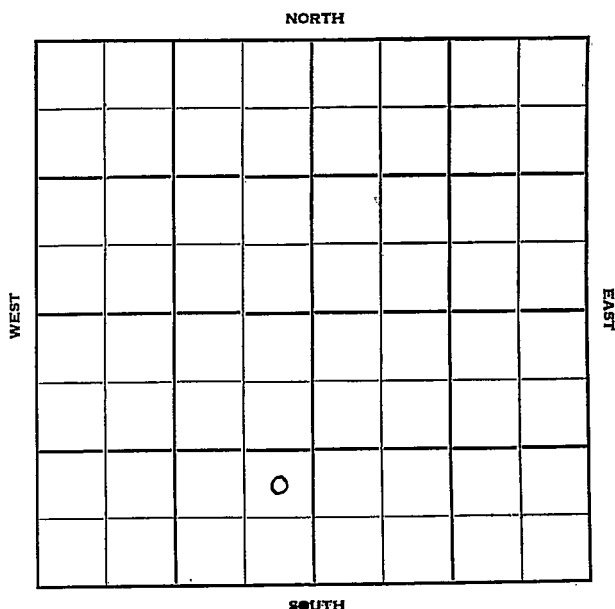


Section 11 Township 17 Range 10 WWell No. # 9 FrevertCompany D. R. Lauck

Ellsworth

KANSAS 10 W

Sec. 11 Twp. 17 R. 10 W

Well No. # 9 Frevert Farm

D. R. Lauck Company

Contractor

Stoltenberg Pool


Ft. from N. Line

990 Ft. from S. Line

330 Ft. from E. Line

Ft. from W. Line

NE SE SW

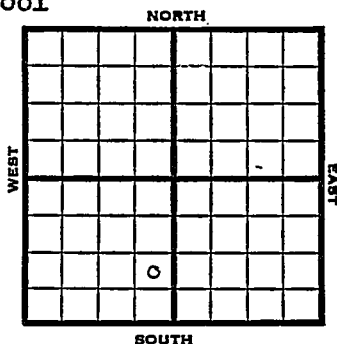

1951

Elev. 1777'

REPORT

5/23

Spud 5-13-51
8" @ 201
Drlg. 3105'

6/20

Spud 5-13-51
Oil Well TD 3253
8" @ 201
Heeb. 2781 Br line 2891
Ians. 2915 Congl 3221
Arb. 3231 TD 3236
5" @ 3233 DD 3257
500 A SSO DD 3263
Comp. 35 bopd

COMPLETED

Scout Cards <i>mm</i>	MAY 25 1951
Land Small Map	
Land Wall Map <i>33</i>	
Tracings	
France Map	
Pierce Map	
Misc.	

Orig. Date

J. E. TYRA

Scout Cards	
Land Small Map	
Land Well Map	3
Trainings	
France Map	
Pierce Map	
Misc.	

5