


Section 11 Township 17 Range 10W

Well No. ~~#8~~ ¹⁰ Frevert

Company E. R. Lauck

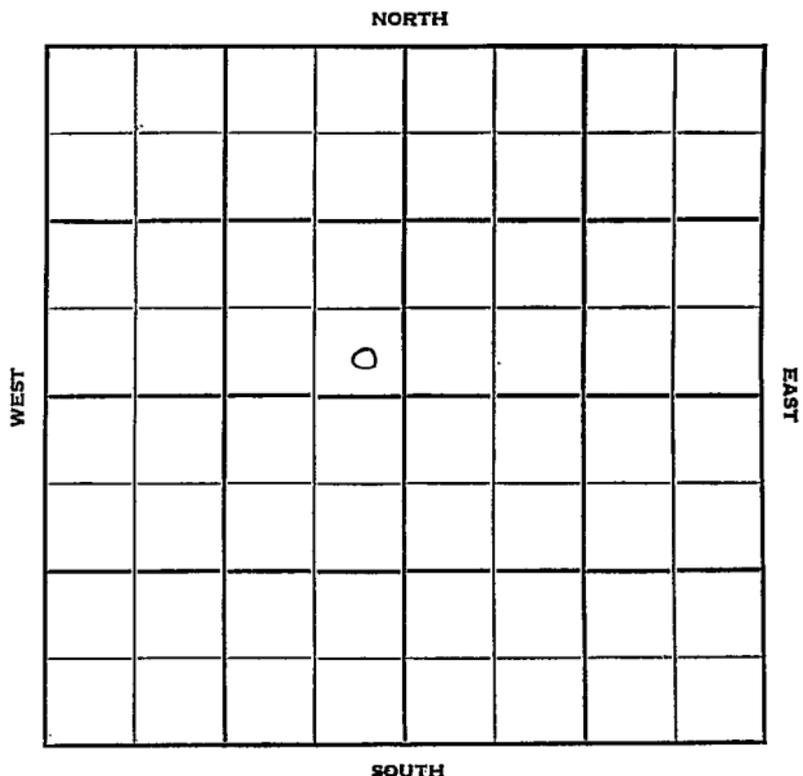

Ellsworth


Sec. 11 Twp. 17 R. 10W

Well No. ~~#10~~ ~~#8~~ **Frevert** Farm

E. R. Lauck Company

Staltenberg Contractor

_____ Ft. from N. Line
330 Ft. from S. Line
330 Ft. from E. Line
 _____ Ft. from W. Line

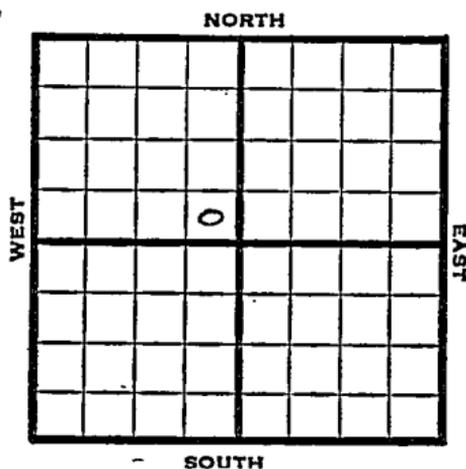

SE SE NW

1952 Elev. 1780' REPORT

2/6 Cellar & pits
 2/13 Drlg. 1830'
 2/20 Heeb. 2782 Br Li 2889
 Lans. 2916 Cong. 3223
 Arb. 3235
 TD 3240 5" @ 3236 WOCT
 2/27 Spud 2-7-52
 D&A TD 3285'
 8" @ 198
 Heeb. 2782 Br Li 3235
 Lans. 2916 Cong. 3223
 Arb. 3235
 TD 3240 5" @ 3236 DD 3265
 S/ free oil 500 A DD 3273 wtr.
 DD 3285
 D&A

ABANDONED

Scout Cards

500

Land Small Map

Land Wall Map

35

Tracings

France Map

Pierce Map

Misc.

FEB 8 1952

Orig. Data

Kansas

Map No. _____ Sec. 11 Twp. 17 R. 10WWell No. 10 FrevertD. R. Lauck Company~~CONTRACTOR~~ Contractor

SE SE NW

SECTION PLAT

_____ Ft. from N. Line

330 Ft. from S. Line330 Ft. from E. Line

_____ Ft. from W. Line

	o		

Ellsworth County

Location _____

Rig up _____

Drilling and Remarks:

Reported
#8 Frevert

RECORD

Cased _____ in., _____ ft.

Sand _____

Gas _____

Oil _____

Total Depth _____

PRODUCTION

1st 24 hrs. Nat. _____

1st 24 hrs. after shot _____

Gas _____ Cu. Ft.

Dry Hole _____

Abandoned _____

Date


FEB 13 1952

19

J. G. McGEHEE

Scout

SECTION PLAT

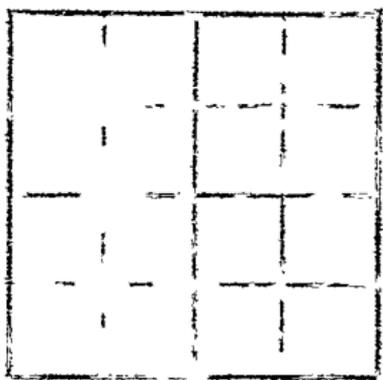

PLAT

- SCOUT CARDS
- Scout Cards _____
 - Land Small Map _____
 - Land Wall Map _____
 - Tracings _____
 - France Map _____
 - Pierce Map _____
 - Misc. _____

FEB 20 1952

Scout Cards
Land Small Map
Land Wall Map
Tracings
France Map
Pierce Map
Misc.

MAR 3 1952