


KANSAS

FORM 51 5M PETROL

Section 11 Township 17 Range 10WWell No. #1 PetermanCompany Weber Dental Mfg.

Bloomer Pool

NORTH

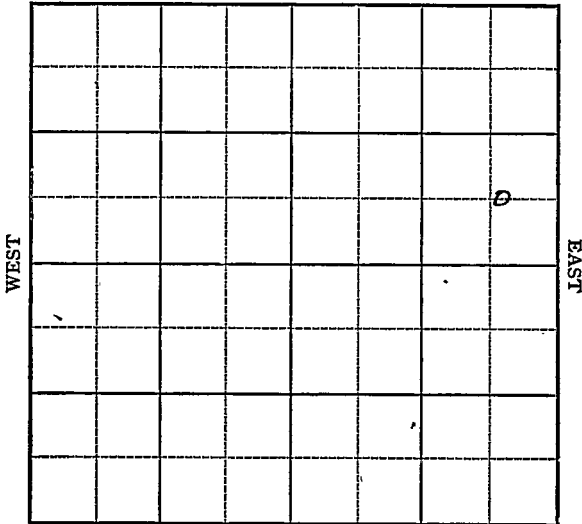

SOUTH

KANSAS

Sec. 11 Twp. 17 R. 10-W

Well No. #1 Peterman Farm

Weber Dental Mfg. Company


C SE NE

 Ft. from N. Line

660 Ft. from S. Line

510 Ft. from E. Line

 Ft. from W. Line

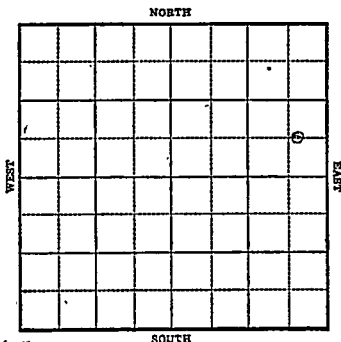

Elev. 1817

1943

R E P O R T

12-29

Location

1944

1-5

8" @ 225
Drlg 1280'

1-12

Drlg 2944'

1/19

Lans 2935
Cong 3255
Arb 3287 SO
3290-95 TD
5" @ 3286'
Rust

1/26

TD 3296-100 scid
2700' oil

2/2

Swb 112 oil in 6 hrx.

2/8

Swb 112 oil in 6 hrs.

2/15

5" @ 3286
Arb 3287
TD 3296'
Pump 327 oil & 3% water
Gravity 41.7

COMPLETED

KANSAS
 Map No. Sec. 11 Twp. 17 R. 10W

Well No. 1 Peterman


Weber Dental Mfg. Company

FIRST REPORT

Contractor

C SE NE

SECTION PLAT

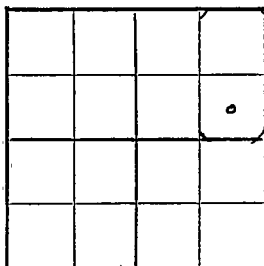

Ft. from N. Line

660

Ft. from S. Line

510

Ft. from E. Line

Ft. from W. Line

Bloomer Pool

Location X

Rig up

Drilling and Remarks:

Rotary

RECORD

Cased in., ft.

Sand

Gas

Oil

Total Depth

PRODUCTION

1st 24 hrs. Nat.

1st 24 hrs. after shot

Gas Cu. Ft.

Dry Hole

Abandoned

Date

DEC 29 1943

19

S. J. LEWIS

Scout

Map No. KANSAS Sec. 11 Twp. 17 R. 10W

Well No. 1. Peter man

Weber Dental Mfg. Company

COMPLETED Contractor

C SE NE

SECTION PLAT

			o

Ft. from N. Line

660

Ft. from S. Line

510

Ft. from E. Line

Ft. from W. Line

Bloomer Pool

Location _____

Rig up _____

Drilling and Remarks:

Cor 83287

5" @ 3286

1000 acid

Pump. 327 oil +

3% Water

4 1/2 Gr

RECORD

Cased _____ in., _____ ft.

Sand _____

Gas _____

Oil _____

Total Depth 3296

PRODUCTION

1st 24 hrs. Nat. _____

1st 24 hrs. after shot _____

Gas _____ Cu. Ft.

Dry Hole _____

Abandoned _____

Date

FEB 16, 1944 19

S. J. LEWIS Scout