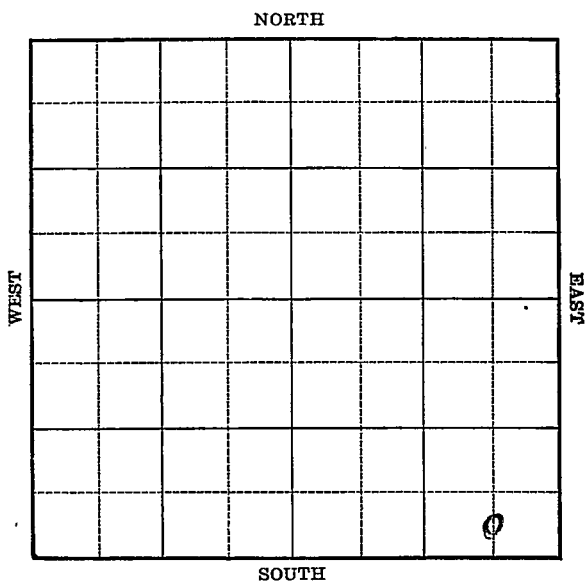


KANSAS


Ellsworth

Form 51—5M—7-40—Palace

Section 11 Township 17 Range 10-WWell No. #1 PetermanCompany Derby Oil

Sec. 11 Twp. 17 R. 10-WWell No. #1 Peterman FarmDerby Oil Company

(Bloomer)

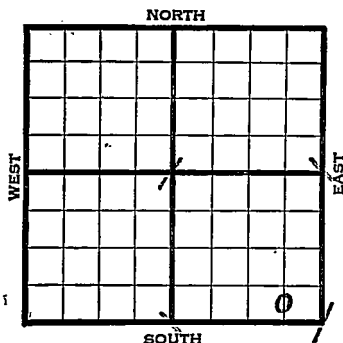 Ft. from N. Line330 Ft. from S. Line660 Ft. from E. Line Ft. from W. Line

Elev. 1812

1941

REPORT

2/12

S. H.

2/20

8" - 226' Drlg. 2206'

2/27

Lans. 2924' Arb. ³²⁶⁴~~3274~~ - 32' T.D.4" - ³²⁶⁶~~3276~~ RUST.

3/6

Arb. 3264' (Corrected)

4" - 3266' T.D. 3285'

14 qts. 3283 $\frac{1}{2}$ -71' 1000 acid.

Swab 32 bbls. oil in 4 hours.

3/13

" " "

3/19

Arb. 3264'

4" - 3266'

T.D. 3285'

Shot 14 qts. 3283 $\frac{1}{2}$ -71'

1000 acid.

Potential 200 bbls., pump.

42.6 Gravity

COMPLETED

Map No. 55 Sec. 11 Twp. 17 R. 10WWell No. 1 Peterman

Derby Oil

Company

Contractor

FIRST REPORT

C S L S E S E


Ft. from N. Line

330 Ft. from S. Line660 Ft. from E. Line

Ft. from W. Line

BLOOMER POOL

SECTION PLAT

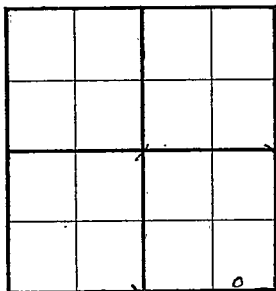

Location

Rig up

Drilling and Remarks:

S. H.

RECORD

Cased _____ in., _____ ft.

Sand _____

Gas _____

Oil _____

Total Depth _____

PRODUCTION

1st 24 hrs. Nat. _____

1st 24 hrs. after shot _____

Gas _____ Cu. Ft.

Dry Hole _____

Abandoned _____

Date
FEB 12 1941

19

S. J. LEWIS Scout

Map No. 53 Sec. 11 Twp. 17 R. 10WWell No. 1 PetermanDerby Oil

Company


Contractor

COMPLETED**SECTION PLAT**

C S L SE SE

 Ft. from N. Line330 Ft. from S. Line660 Ft. from E. Line Ft. from W. Line

BLOOMER POOL

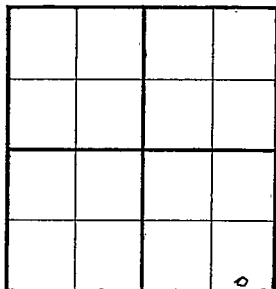Location Rig up

Drilling and Remarks:

*CR 83264**4" 83266**149 to 328 1/2 - 71**1000 acid**Pump 200 Ps**42 6 Gr***RECORD**Cased in., ft.Sand Gas Oil Total Depth 3285**PRODUCTION**1st 24 hrs. Nat. 1st 24 hrs. after shot Gas Cu. Ft.Dry Hole Abandoned

Date

MAR 19 1941 19

S. J. LEWIS Scout