


Section 11 Township 17 Range 10-W

Well No. #1 Peterman

Company Goodpastore et al

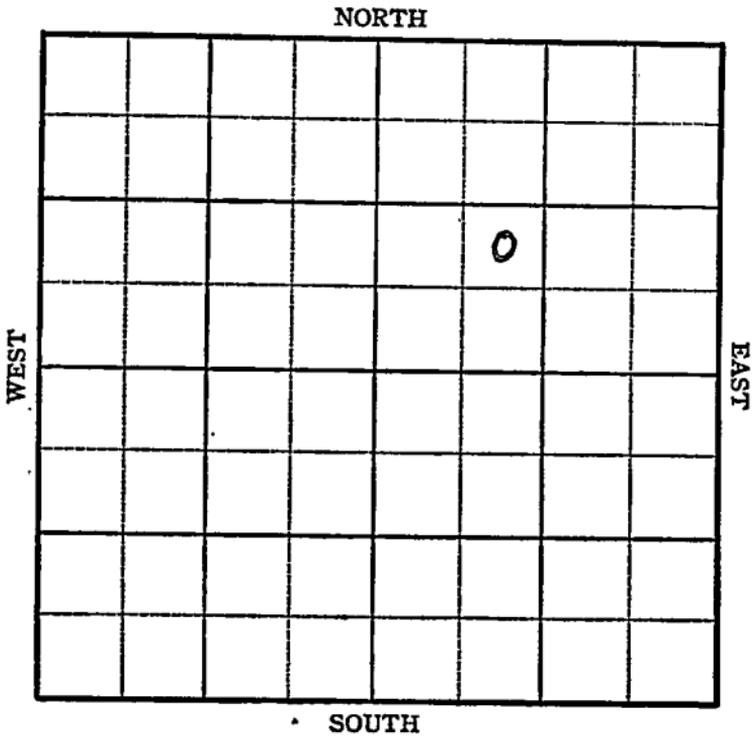

Sec. 11 Twp. 17 R. 10-W

Well No. #1 Peterman Farm


Goodpasture et al Company

 Ft. from N. Line

990 Ft. from S. Line

 Ft. from E. Line

990 Ft. from W. Line

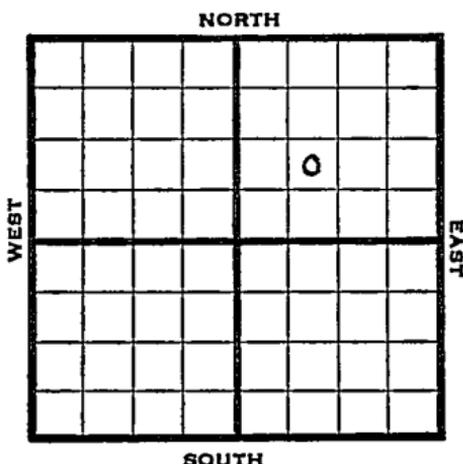

NE SW NE.

1945 Elev. 1796' REPORT

12/12	8" @ 450'		
	Lans 2918'		
	Cong 3221'		
	ReArb 3242'		
	Arb. 3248'		
	5" @ 3251'	RUST	
12/20	" "		
12/29	" "		
1946			
1/10	" "		
1/17	T.D. 3261'	500' oil 8 hours.	
	500 acid.	Bail 3 oil per hour 8 hrs.	
1/24	" "	" "	
1/31	" "	" "	
2/7	" "	" "	
2/14	" "	" "	
2/21	" "	" "	
2/28	" "	" "	
3/7	" "	" "	
3/14	1000 acid.		
3/21	" "		
3/28	" "		
4/4	" "		
4/10	Arb. 3248'		
	5" @ 3251'		
	1500 acid.		
	TD 3261'		
	Pump 12 Pot.		
	Grav. 42.0		

COMPLETED


KANSAS Kansas Pool Name StoltenbergMap No. A-35 Sec. 11 Twp. 17 R. 10WWell No. 1 PetermanGoodpasture etal Company

FIRST REPORT

Contractor

NE SW NE

SECTION PLAT

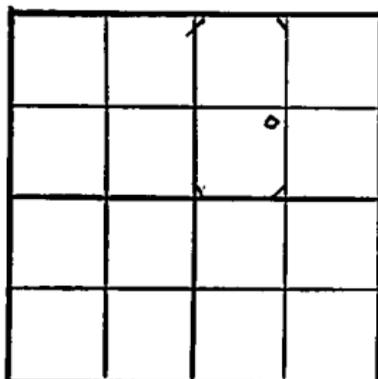

Ft. from N. Line

990 Ft. from S. Line

Ft. from E. Line

990 Ft. from W. Line

Ellsworth County

Location _____

Rig up _____

Drilling and Remarks:

8"-450

Lans 2918

Con 3221

ReArb 3242

Arb. 3248

5"-3251 RUST

RECORD

Cased _____ in, _____ ft.

Sand _____

Gas _____

Oil _____

Total Depth _____

PRODUCTION

1st 24 hrs. Nat. _____

1st 24 hrs. after shot _____

Gas _____ Cu. Ft.

Dry Hole _____

Abandoned _____

Date

DEC 1 2 1945 19

S. J. LEWIS Scout

