


Section 11 Township 17 Range 10-W

Well No. #2 Peterman

Company Derby

(Stoltenberg)

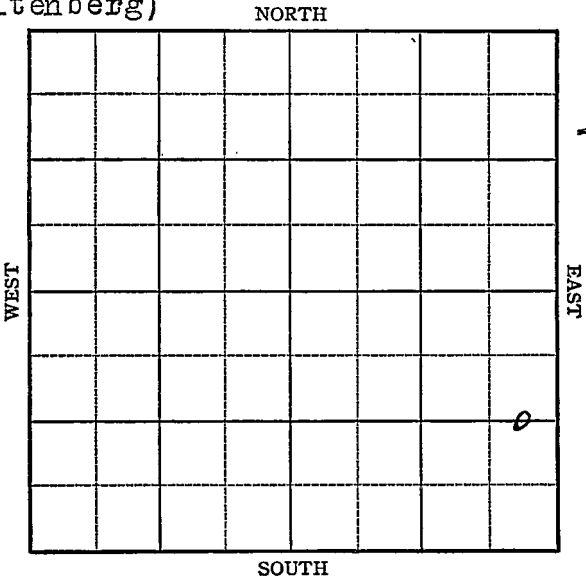

**KANSAS**

Ellsworth

Sec. 11 Twp. 17 R. 10-W

Well No. #2 Peterman Farm

Derby

Company


(Stoltenberg)

1320 Ft. from N. Line

Ft. from S. Line

330 Ft. from E. Line

Ft. from W. Line

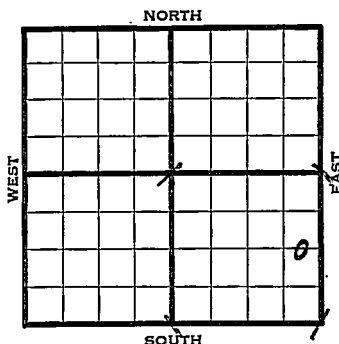

1941

REPORT

12/10

Location.

12/18

Drlg. 1532

12/24

8" - 255' Drlg. 3080'

12/30

Lans. 2935

Cong. 3254

Arb. 3289

TD 3303

No shows

**ABANDONED**

Map No. 55 Sec. 11 Twp. 17 R. 10WWell No. 2 PetermanDerby


Company

FIRST REPORT

Contractor

C E L S E

## SECTION PLAT

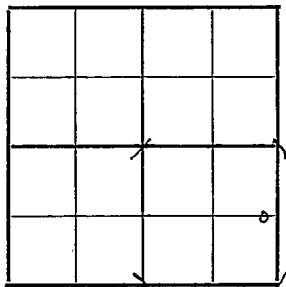1320 Ft. from N. Line

Ft. from S. Line

330 Ft. from E. Line

Ft. from W. Line

## STOLTENBERG POOL

## RECORD

Location XX

Cased \_\_\_\_\_ in., \_\_\_\_\_ ft.

Rig up \_\_\_\_\_

Sand \_\_\_\_\_

Drilling and Remarks:

Gas \_\_\_\_\_

Oil \_\_\_\_\_

Total Depth \_\_\_\_\_

## PRODUCTION

1st 24 hrs. Nat. \_\_\_\_\_

1st 24 hrs. after shot \_\_\_\_\_

Gas \_\_\_\_\_ Cu. Ft.

Dry Hole \_\_\_\_\_

Abandoned \_\_\_\_\_

Date


DEC 10 1941 19S. J. LEWIS Scout

Map No. 53 Sec. 11 Twp. 17 R. 10WWell No. 2 PetermanDerby CompanyABANDONED Contractor

C E L S E

1320 Ft. from N. Line       Ft. from S. Line330 Ft. from E. Line       Ft. from W. Line

## SECTION PLAT

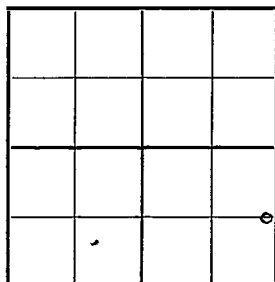

## STOLTENBERG POOL

## RECORD

Location                     Cased            in.,            ft.Rig up                     Sand                     

Drilling and Remarks:

Gas                     Oil                     Total Depth 3213

## PRODUCTION

1st 24 hrs. Nat.                     1st 24 hrs. after shot                     Gas                      Cu. Ft.Dry Hole                     Abandoned                     

Date

DEC 30 194119S. J. LEWIS Scout

*Lease 2935*  
*Comp 3254*  
*Oil 3289*  
*No shows*